

# PLAT AND RECORD

Of a Survey on Section 11 T 1 R 13 E. of the 4 P. M. in Turtle Township


Rock County, Wisconsin, made May the 29<sup>th</sup> 1865

I hereby certify that the following is a correct record of said survey as made by me.

COUNTY BUILDING  
IN CITY OF БЕЛОIT

(Signed) S. D. Locke

County Surveyor.

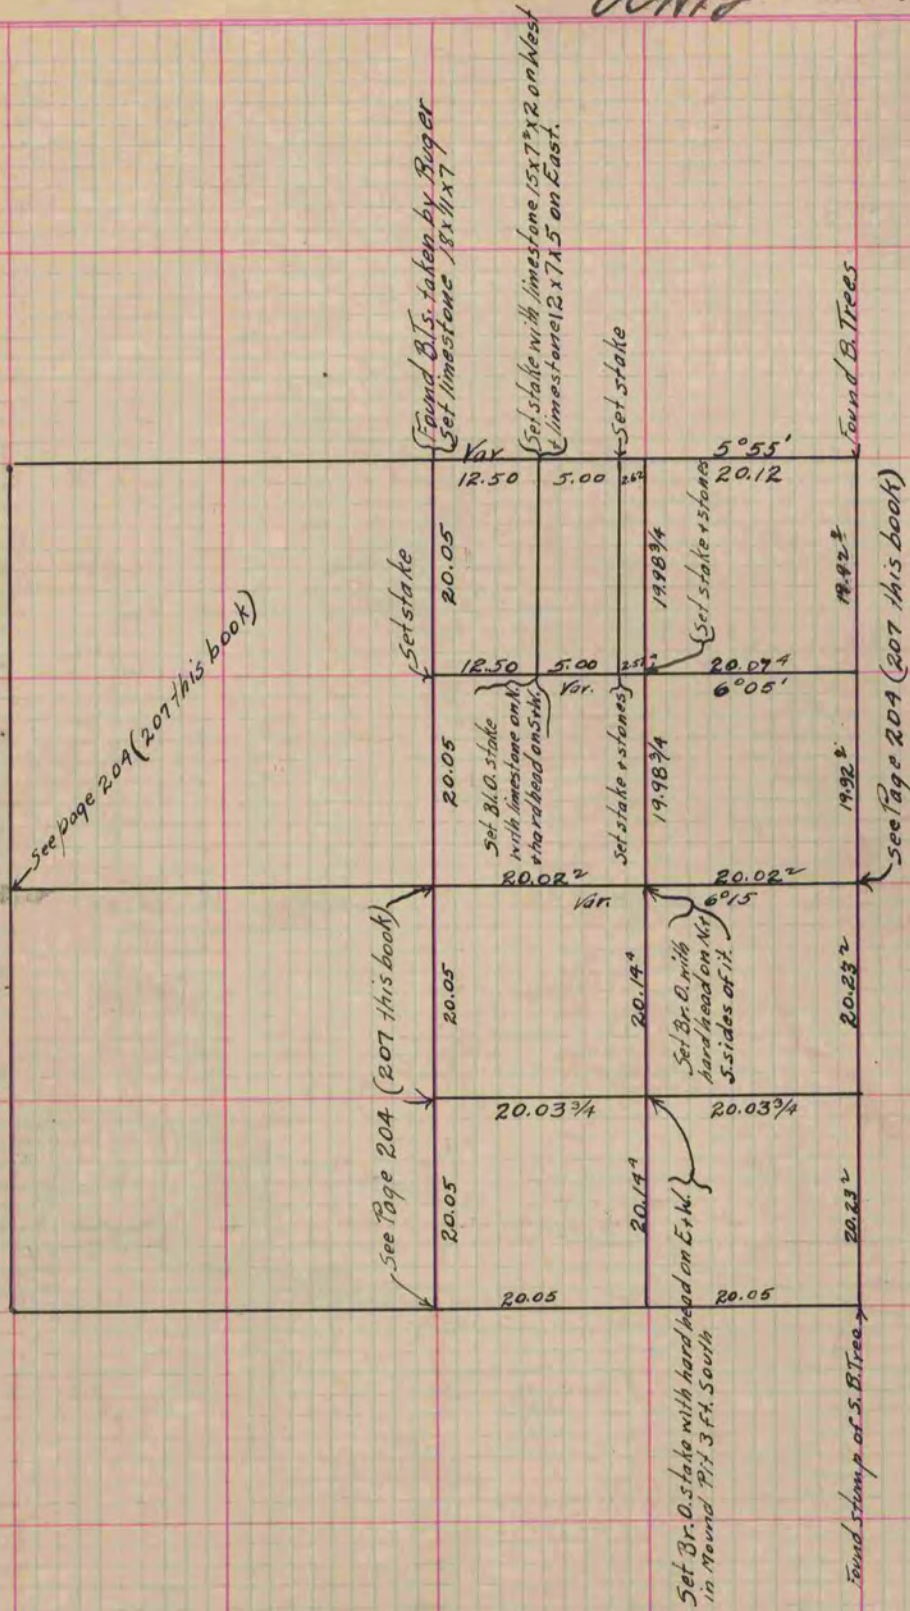

Copied from Page 220 Vol. 1. Original County Surveyors Record.