

PLAT AND RECORD


Of a Survey on Section 29 T. 4 R. 12 E. of the 4 P. M. in *Fulton* Township
Rock County, Wisconsin, made *October* the *9* 18*84*

I hereby certify that the following is a correct record of said survey as made by me.

COUNTY BUILDING
IN CITY OF БЕЛОIT

(Signed) *Edward Rugev*
RRS

County Surveyor.

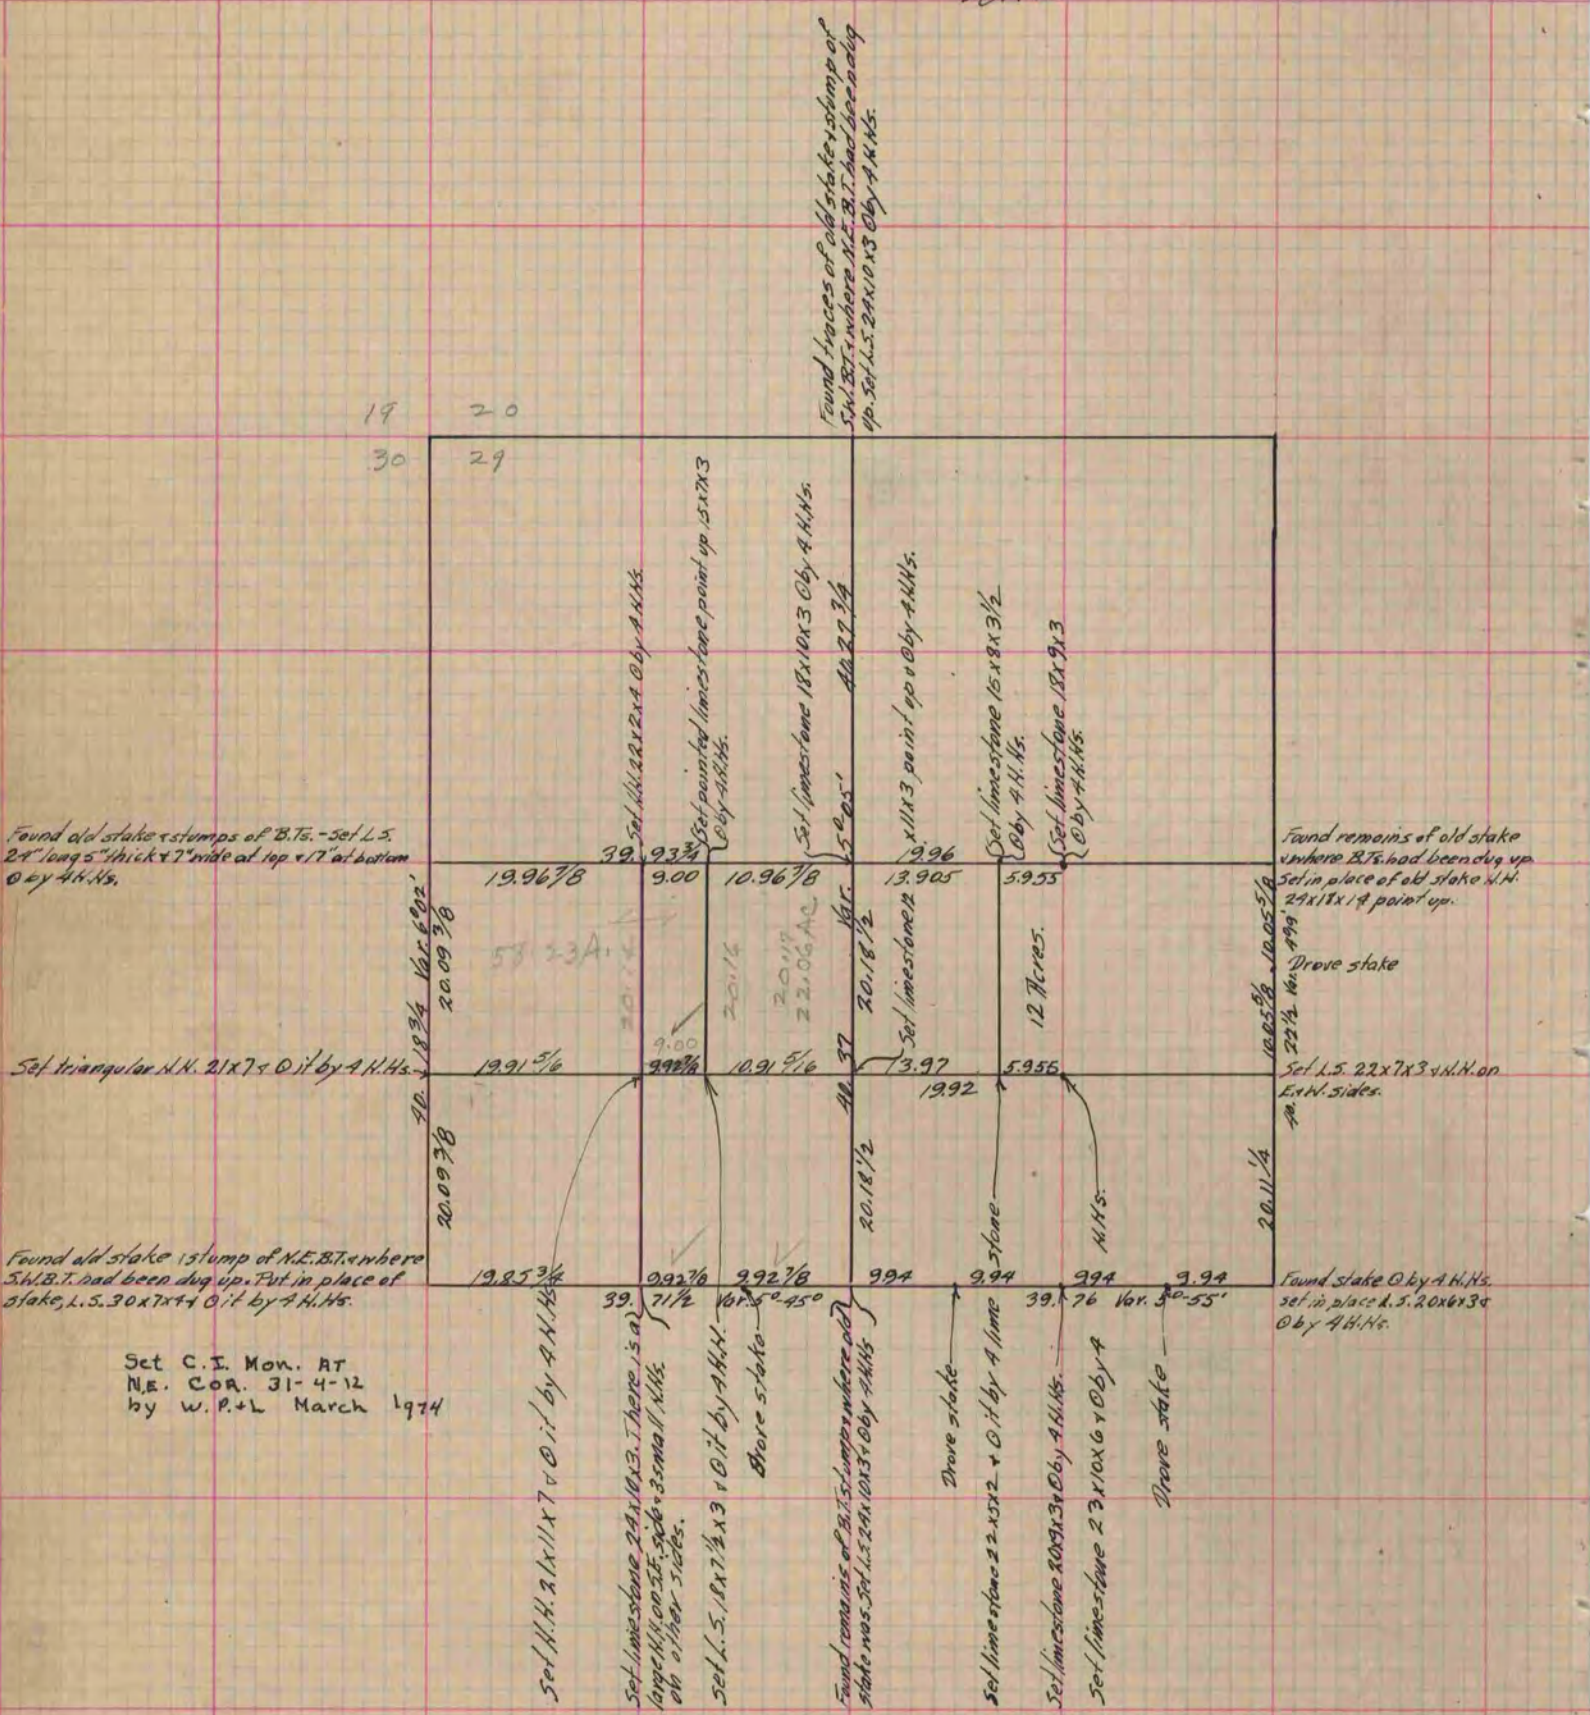

Copied From P. 306 Vol. 2 County Surveyor's Record