

# PLAT AND RECORD

Of a Survey on Section 2 T 4 R 10 E. of the 4 P. M. in Union Township


Rock County, Wisconsin, made April the 29 1884

I hereby certify that the following is a correct record of said survey as made by me.

COUNTY BUILDING  
IN CITY OF БЕЛОIT

(Signed) Edward Ruger

County Surveyor.

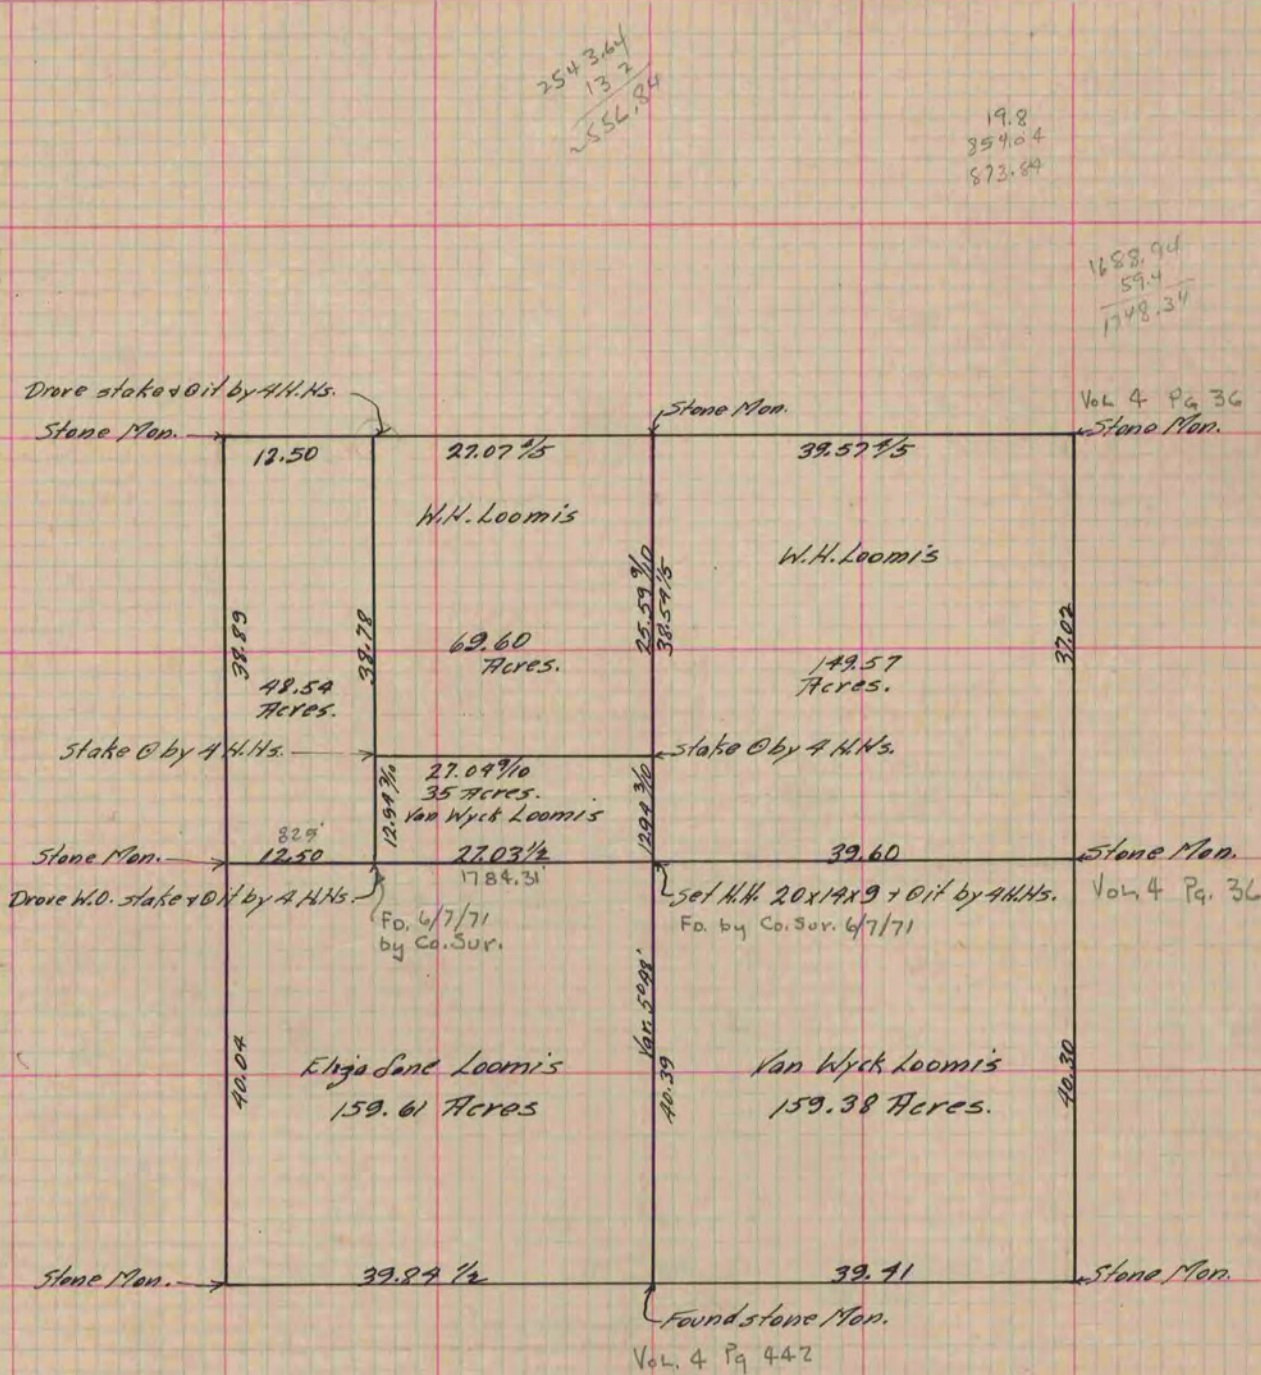

Copied from P. 311 Vol. 2 County Surveyor's Record.