

PLAT AND RECORD

REC 12/15/75 DAB


Of a Survey on Section 34 & 45 T 3 N. R 13 E. of the 4 P. M. in Johnstown Township

Rock County, Wisconsin, made Dec. the 4 1935

I hereby certify that the following is a correct record of said survey as made by me.

COUNTY BUILDING
IN CITY OF BELOIT

B. B. Bunn
County Surveyor.

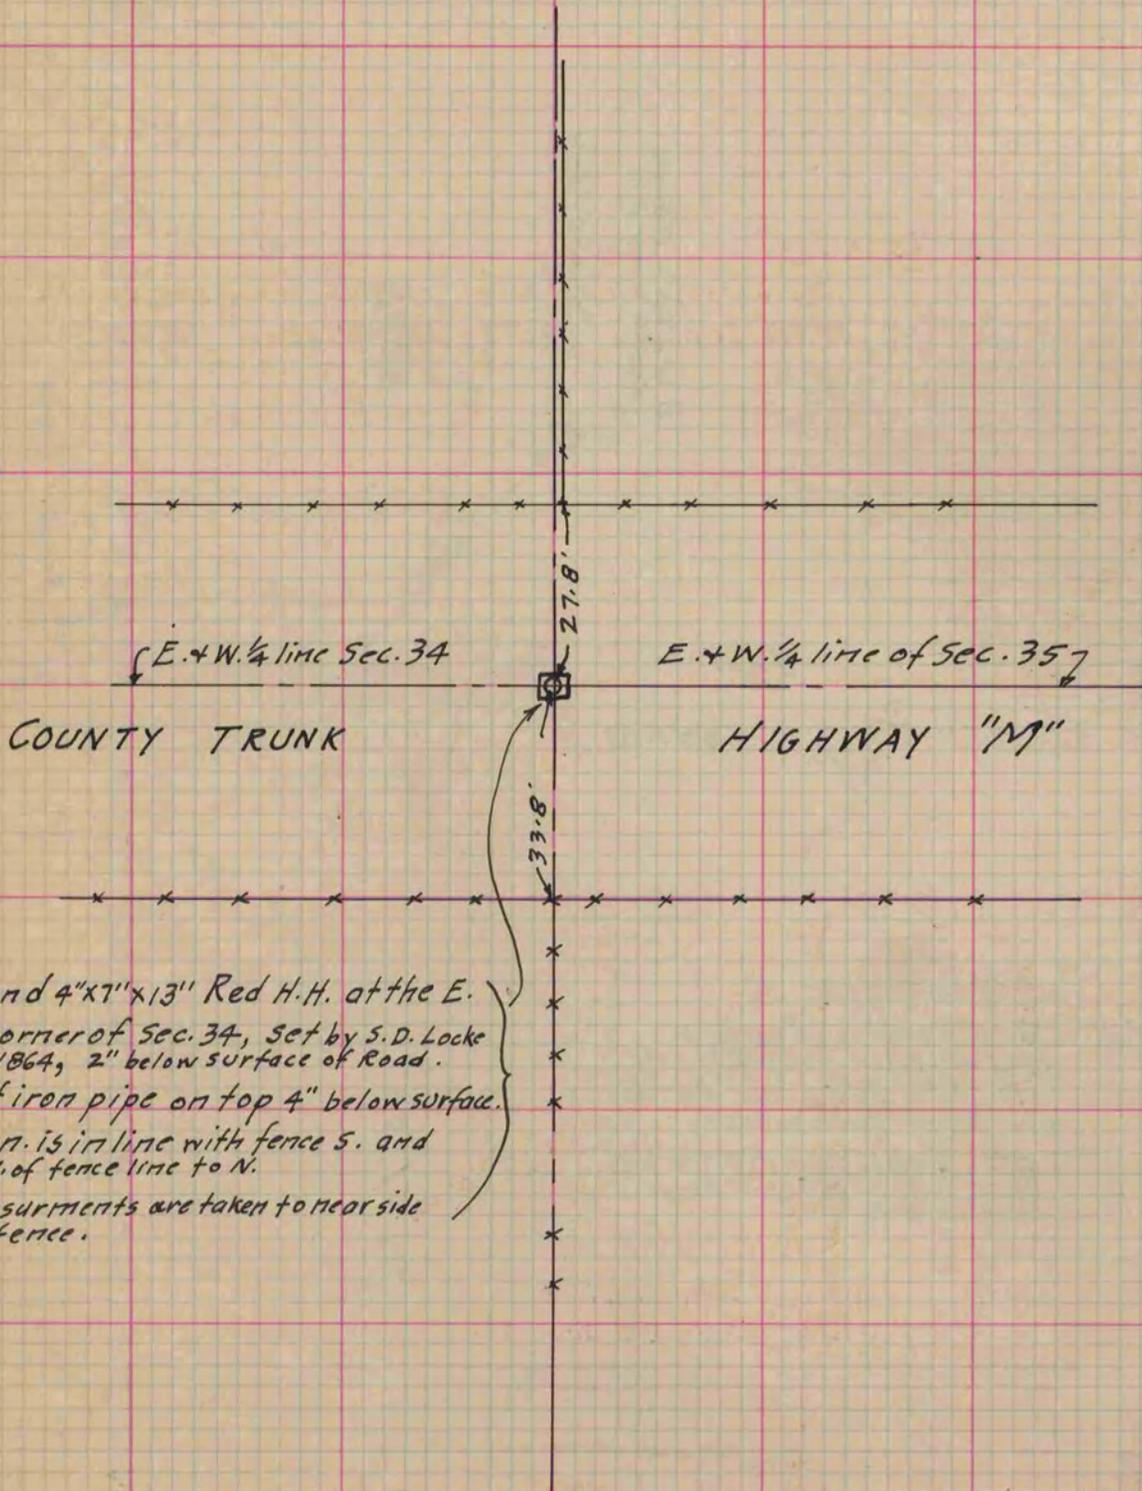

Found 4"x7"x13" Red H.H. at the E. 1/4 Corner of Sec. 34, set by S.D. Locke in 1864, 2" below surface of Road. Set iron pipe on top 4" below surface. Mon. is in line with fence S. and 1' W. of fence line to N. Measurements are taken to near side of fence.