

# PLAT AND RECORD


Of a Survey on Section 17 T 3 R 14 E. of the 4 P. M. in Johnstown Township  
Rock County, Wisconsin, made June the 27+28 1873

I hereby certify that the following is a correct record of said survey as made by me.

COUNTY BUILDING  
IN CITY OF БЕЛОIT

(Signed) Edward Ruger  
RMR

County Surveyor.

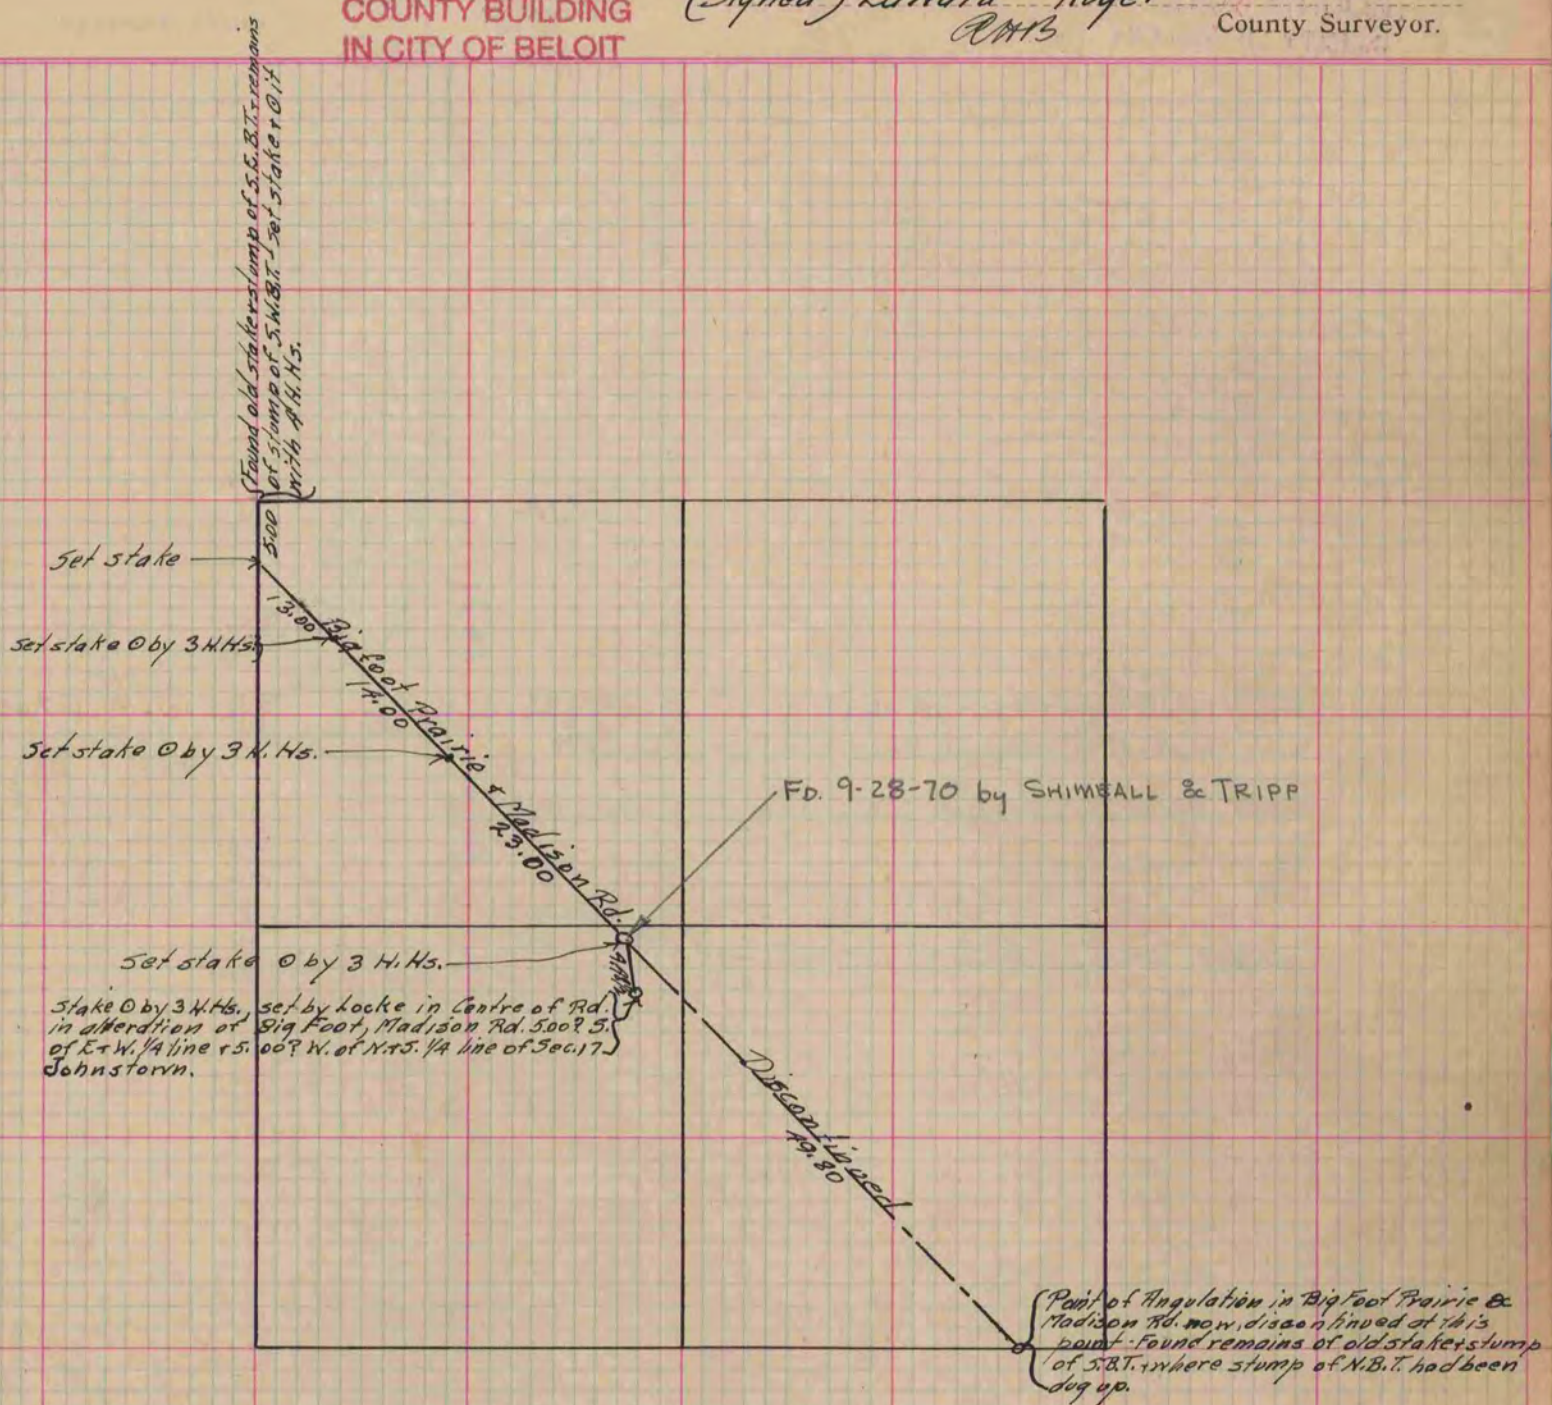

Re-survey of a portion of the Bigfoot-Prairie & Madison Road through the N.W. 1/4 of Sec. 17 Johnstown.

Copied from Page 63 Vol. 2 Original County Surveyor's Record.