

PLAT AND RECORD


Of a Survey on Section 19 T 4 R 11 E. of the 4 P. M. in Porter Township
Rock County, Wisconsin, made July the 18th 1899

I hereby certify that the following is a correct record of said survey as made by me.

COUNTY BUILDING
IN CITY OF BELOIT

(Signed) Perry F. Brown
PFB

County Surveyor.

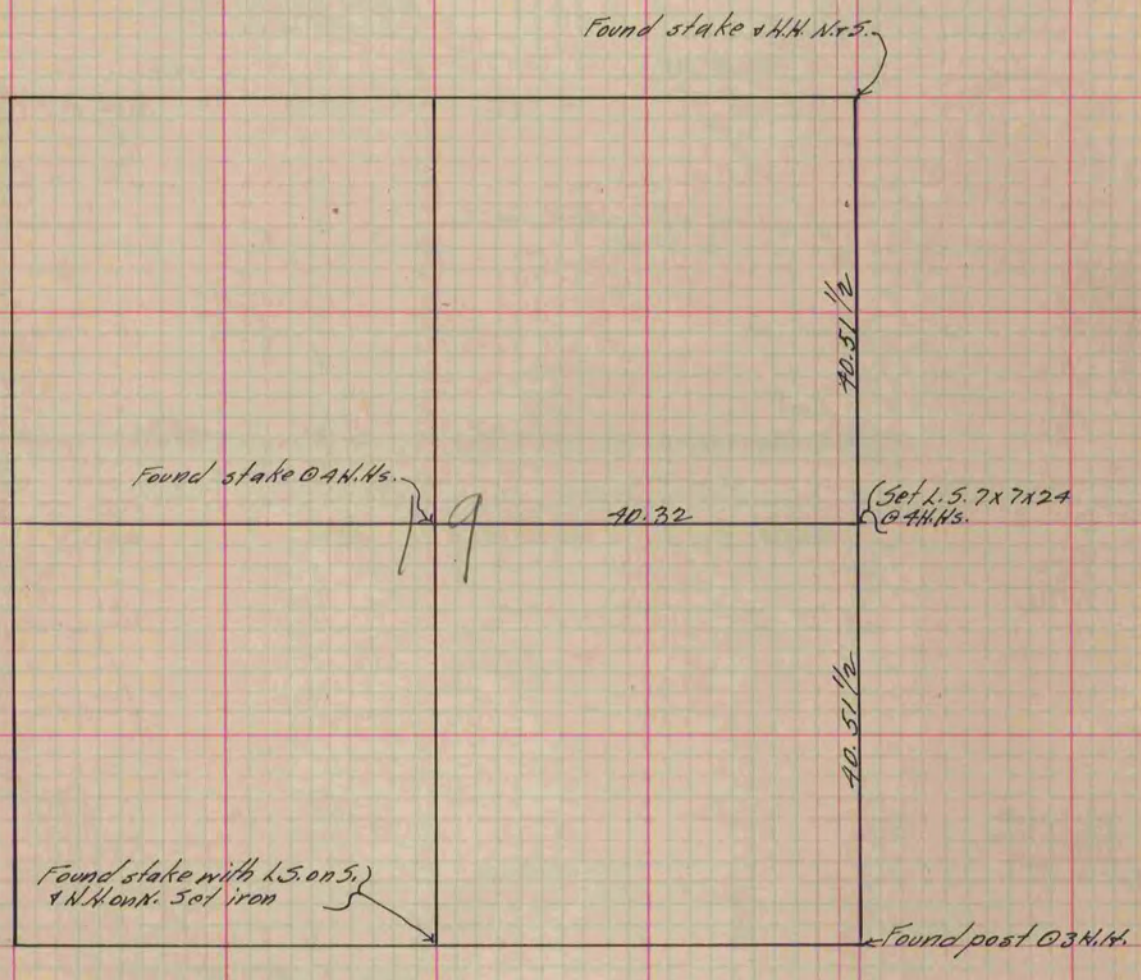

Copied from P. 510 Vol. 2 County Surveyor's Record.