

PLAT AND RECORD


Of a Survey on ^{NE 1/4} Section 8 T A R 12 E. of the 4 P. M. in Fulton Township
 Rock County, Wisconsin, made April the 29 1899

I hereby certify that the following is a correct record of said survey as made by me.

COUNTY BUILDING
 IN CITY OF БЕЛОIT

(Signed) Perry F. Brown
P.F.B.

County Surveyor.

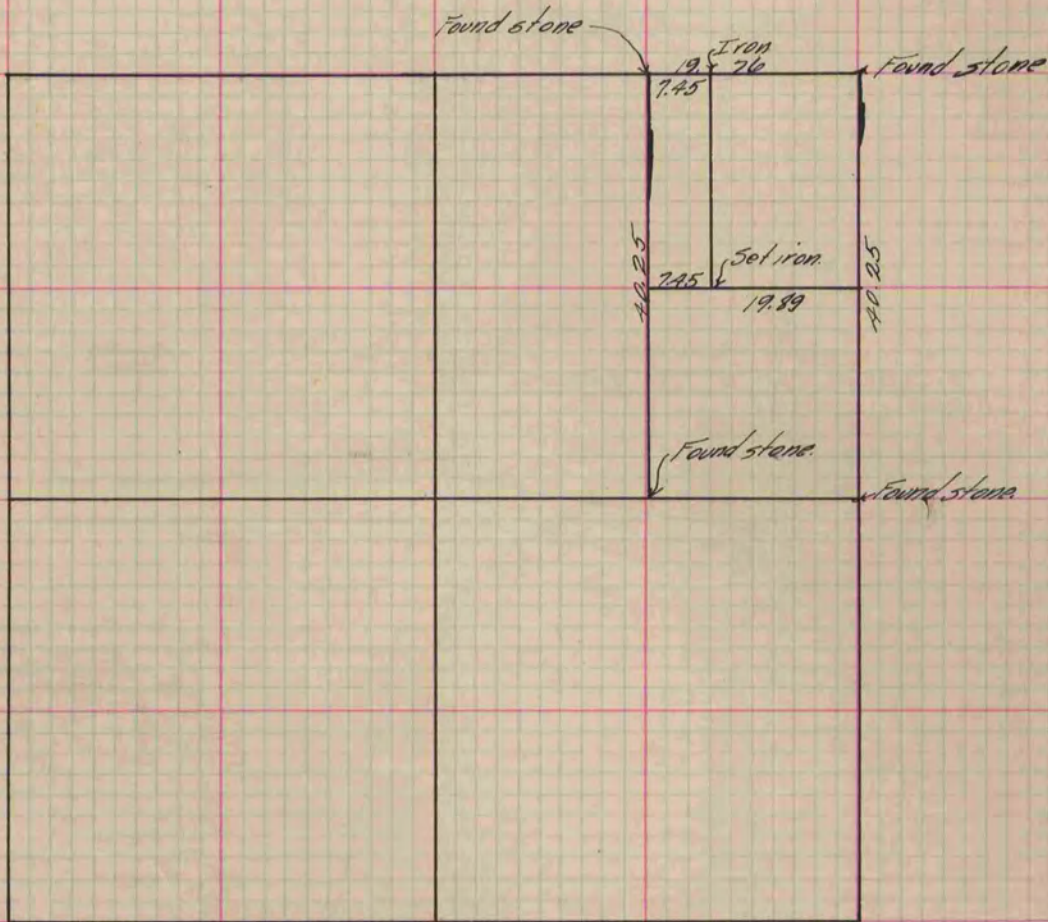

Copied from P. 385 County Surveyor's Record.