

PLAT AND RECORD

Of a Survey on Section 17 T 4 N. R. 14 E. of the 4 P. M. in LIMA Township


Rock County, Wisconsin, made MARCH the 21 19 73

I hereby certify that the following is a correct record of said survey as made by me.

**COUNTY BUILDING
IN CITY OF BELOIT**

Hugh J. Bee
County Surveyor.

THE GEO. D. BARRETT COMPANY, ST. LOUIS

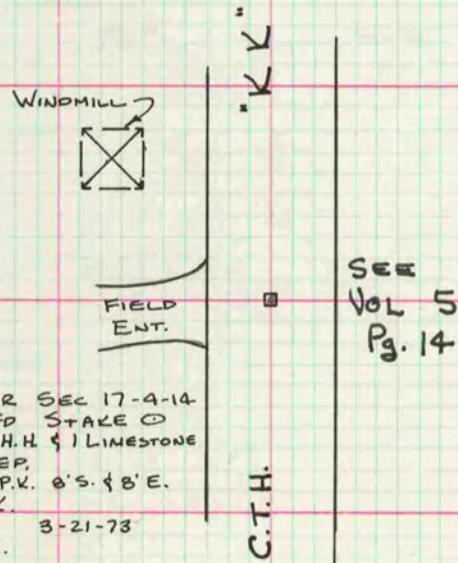

S.E. COR SEC 17-4-14
 DUG & FD STAKE \odot
 BY Z.H.H. & I. LINESBOME
 2' DEEP
 REF. P.K. 8'S. & 8'E.
 W.D.K.
 M.L. 3-21-73
 C.E.