


PLAT AND RECORD

43

Of a Survey on Section 11 T 4 N. R. 12 E. of the 4 P. M. in FULTON Township
Rock County, Wisconsin, made MARCH the 22nd 1973

I hereby certify that the following is a correct record of said survey as made by me.

COUNTY BUILDING
IN CITY OF BELOIT

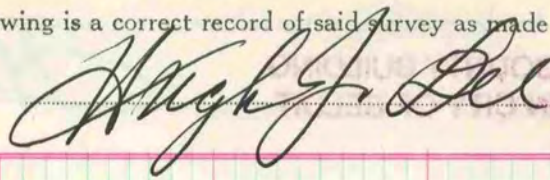

County Surveyor.

ALUM. MON SET
AT NW. COR.
SEC. 11-4-12

