

PLAT AND RECORD


419

Of a Survey on Section 8 T 1 R 11 E. of the 4 P. M. in NEWARK Township

Rock County, Wisconsin, made MAY the 5 1969.


I hereby certify that the following is a correct record of said survey as made by me.

COUNTY BUILDING
IN CITY OF BELOIT

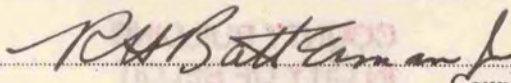


County Surveyor.

THE GEO. B. BARBER COMPANY, ST. LOUIS

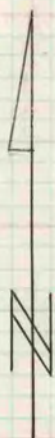

O. S. 5/5/69
B. W.

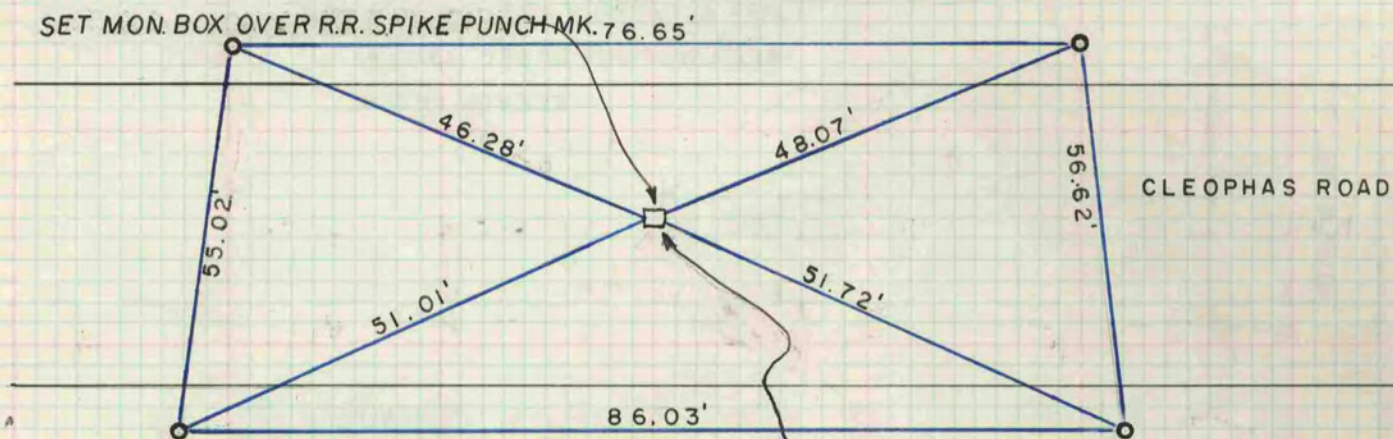

REFERENCES ARE 5/8" PINS.

DUG & FOUND CUT STONE 1.5' DEEP
AT THE S. 1/4 COR., SEC. 8, NEWARK TWP.