

PLAT AND RECORD

157


PG 176 JANESVILLE
REC DAB 12/12/75

Of a Survey on Section 7-8 T 1 R 13 E. of the 4 P. M. in Turtle Township
Rock County, Wisconsin, made October the 1929

I hereby certify that the following is a correct record of said survey as made by me.

R. H. BATTERMAN SR.
County Surveyor.

COUNTY BUILDING
IN CITY OF БЕЛОИТ

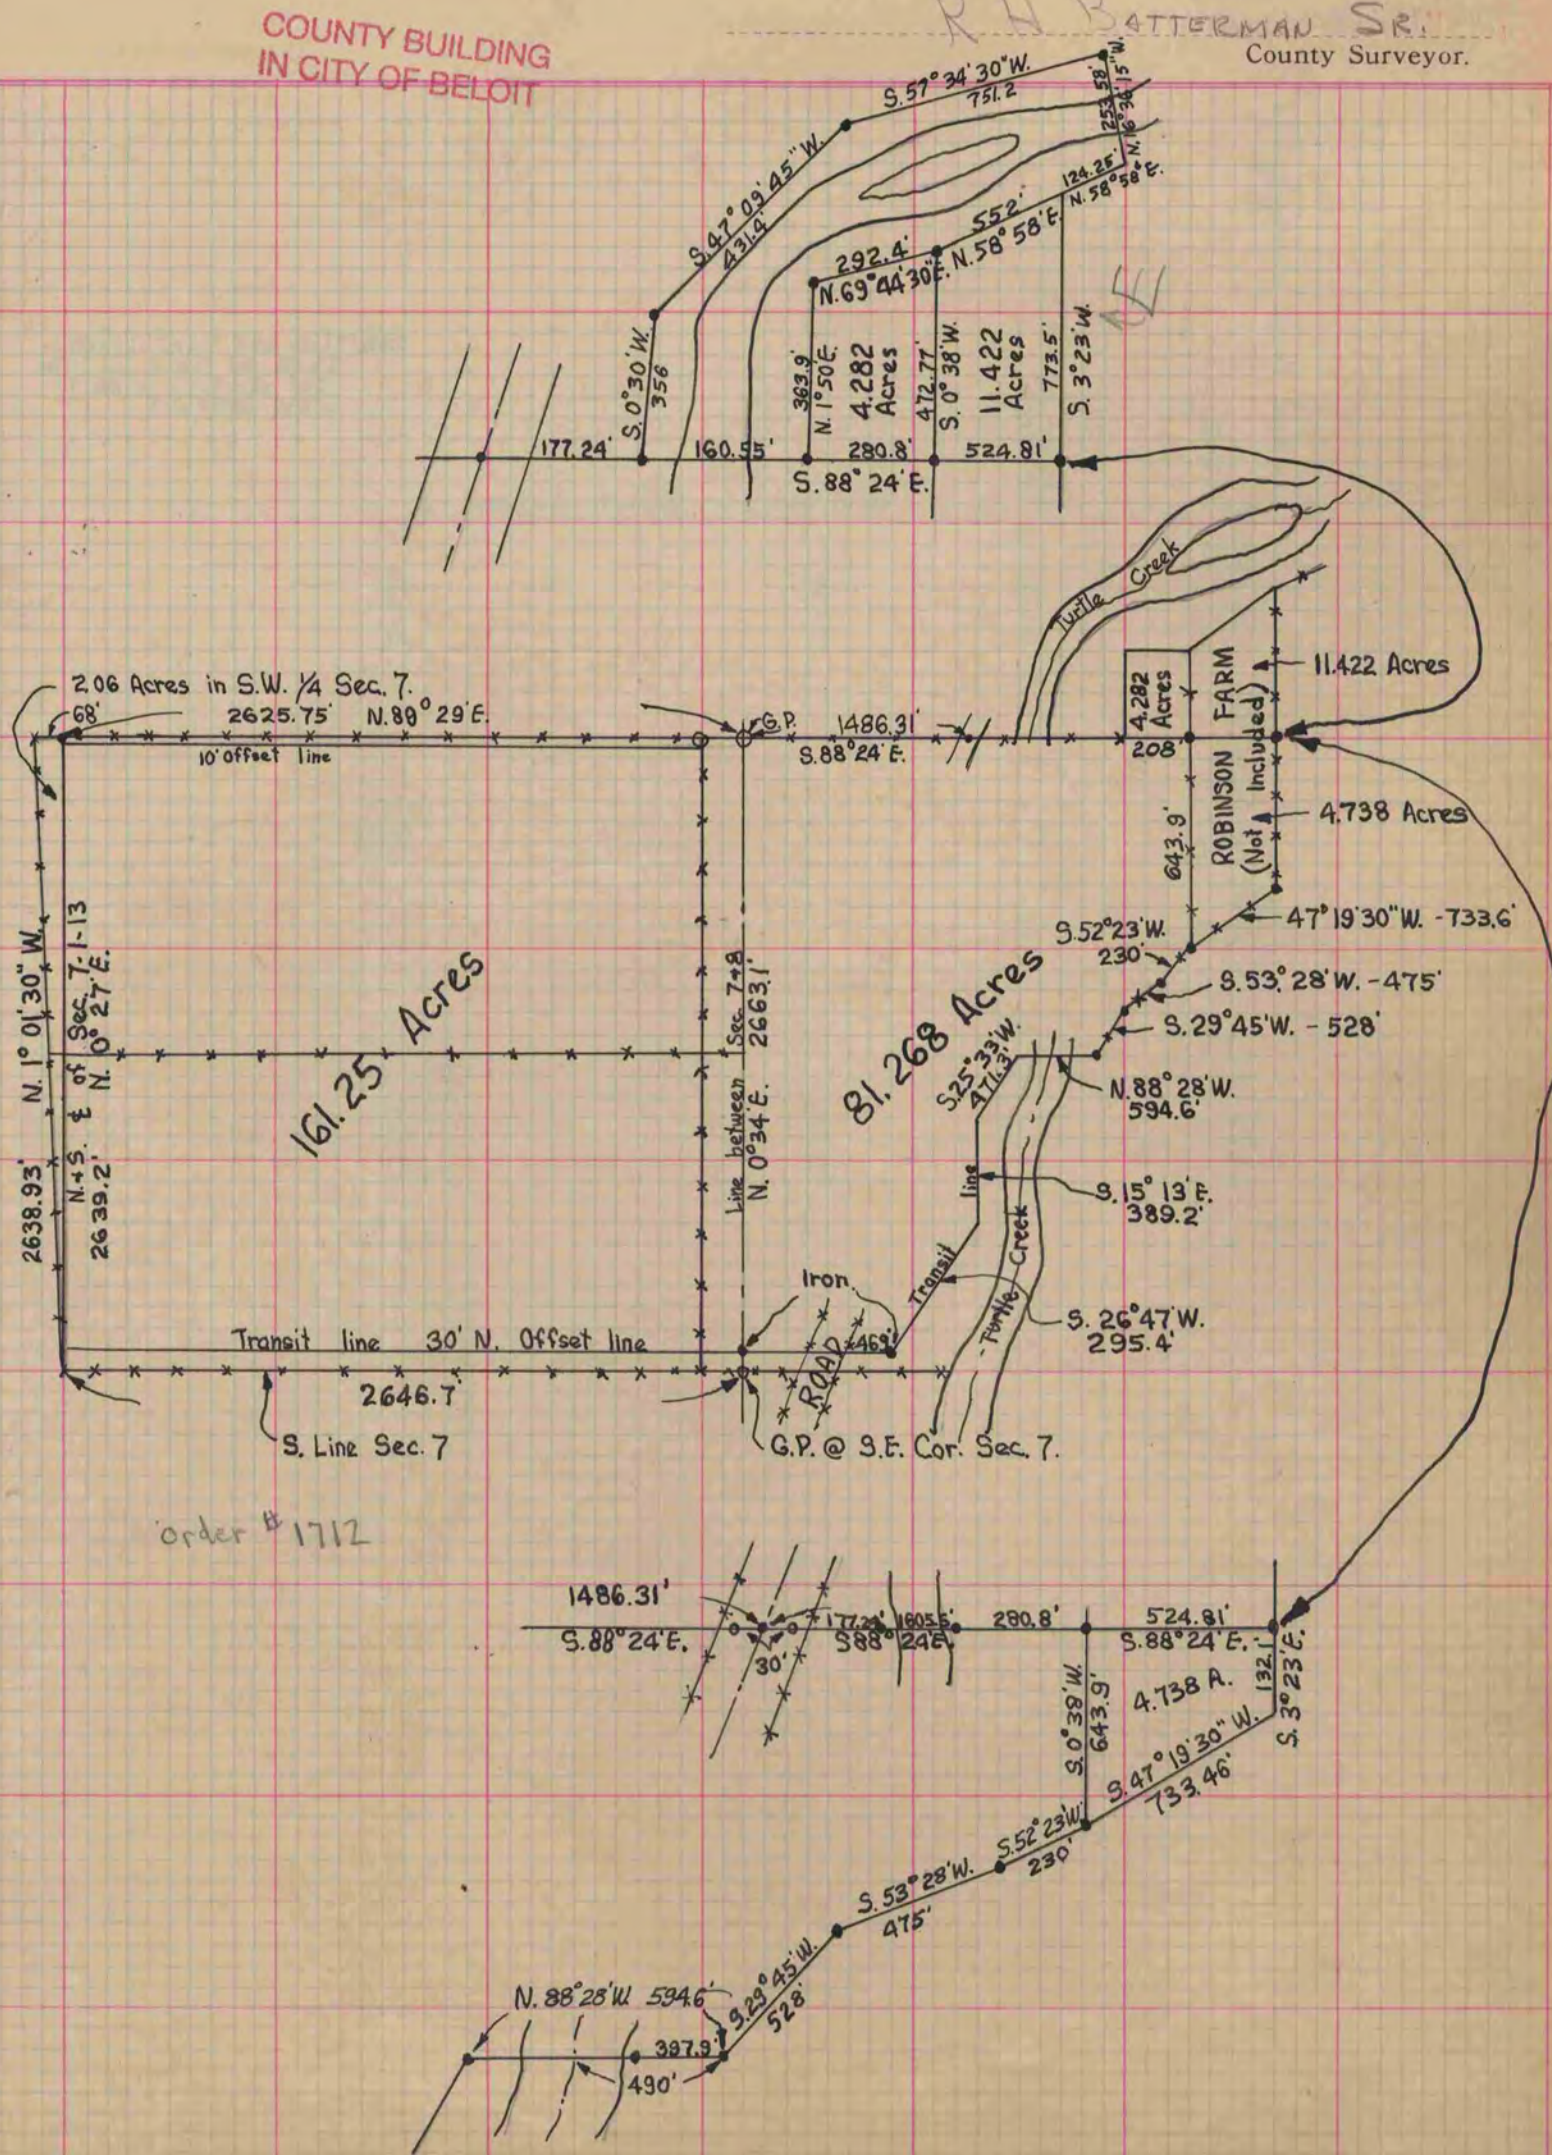

order # 1712