

# PLAT AND RECORD

Of a Survey on Section 33 T / R 10 E. of the 4 P. M. in Avon Township


Rock County, Wisconsin, made August the 19 20 1873

I hereby certify that the following is a correct record of said survey as made by me.

COUNTY BUILDING  
IN CITY OF BELOIT

(Signed) Edward Ruger  
RMR

County Surveyor.

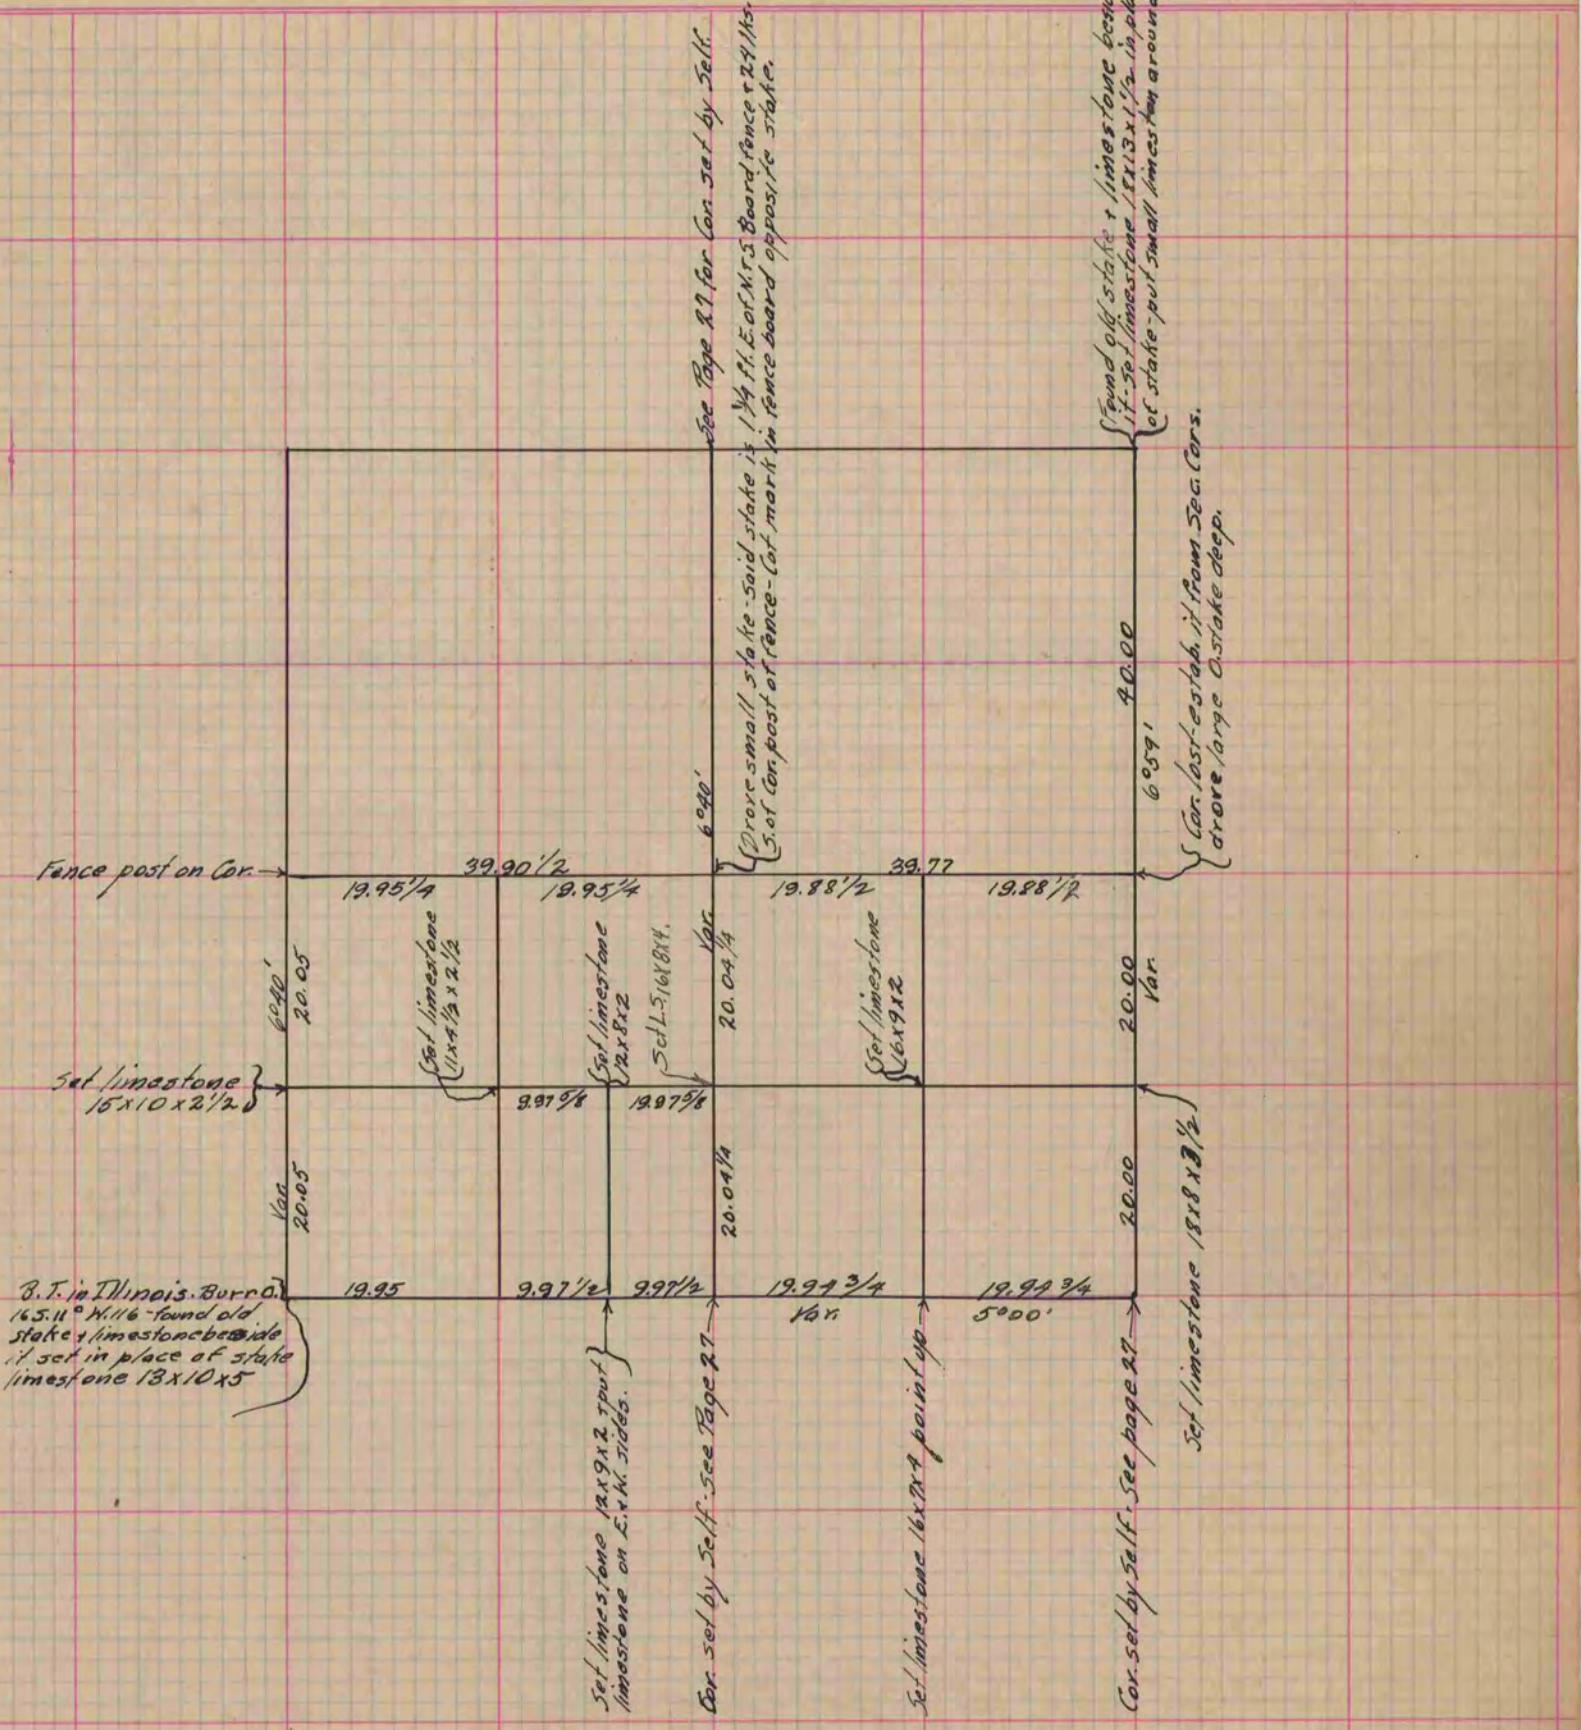

Copied from Page 65 Vol. 2 Original County Surveyor's Record.