

PLAT AND RECORD

179

COUNTY BUILDING
IN CITY OF BELOIT


Of a Survey on Section 30 T 4 R 11 E. of the 4 P. M. in Porter Township

Rock County, Wisconsin, made December the 22, 23 & 24 1874

I hereby certify that the following is a correct record of said survey as made by me.

(Signed) Edward Reger
RER

County Surveyor.

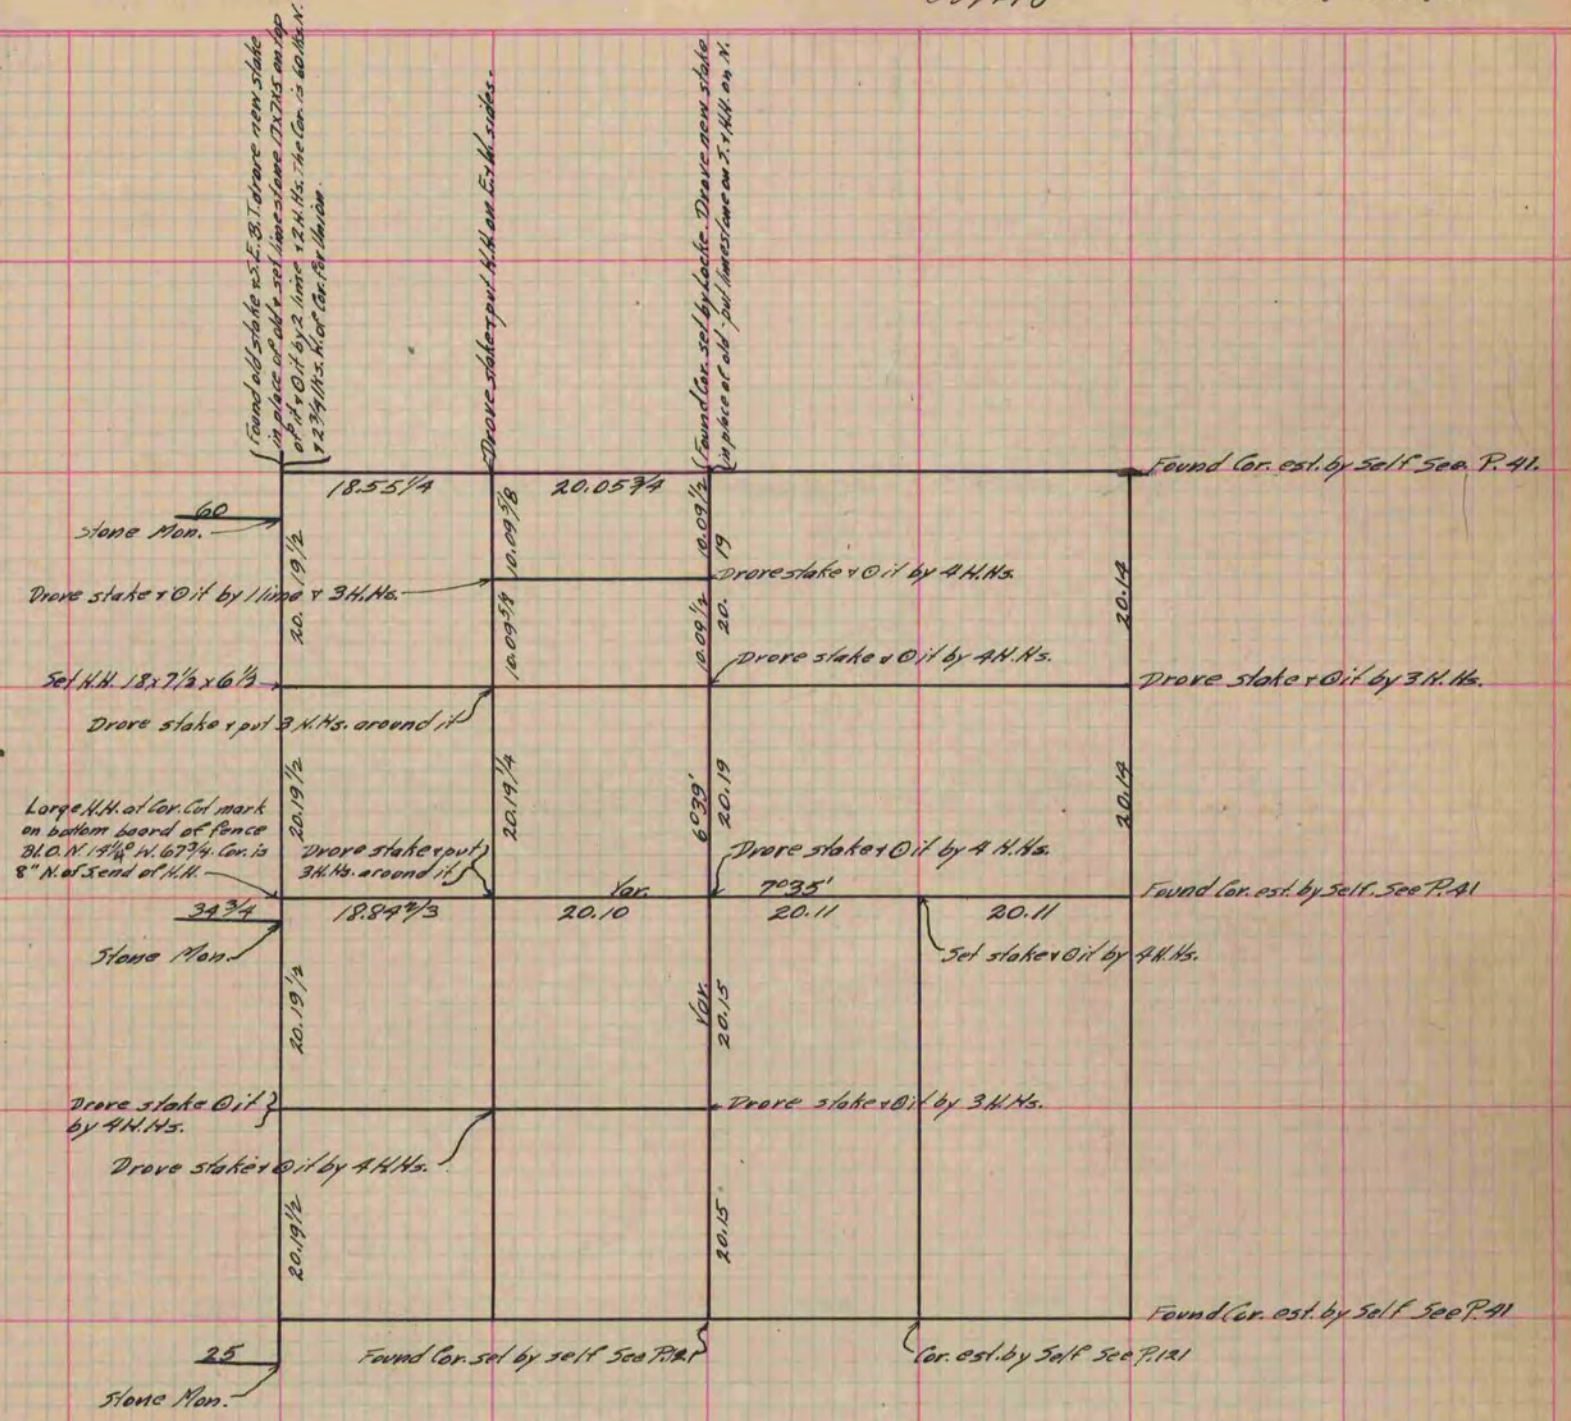

Copied from P. 135 Vol. 2 Original County Surveyors Record.