

PLAT AND RECORD

Of a Survey on Section 19 T 3 R 13 E. of the 4 P. M. in Harmony Township


Rock County, Wisconsin, made November 28-1874 + Jan. the 31st 1884

I hereby certify that the following is a correct record of said survey as made by me.

COUNTY BUILDING IN CITY OF БЕЛОIT

(Signed) Edward Roger

County Surveyor.

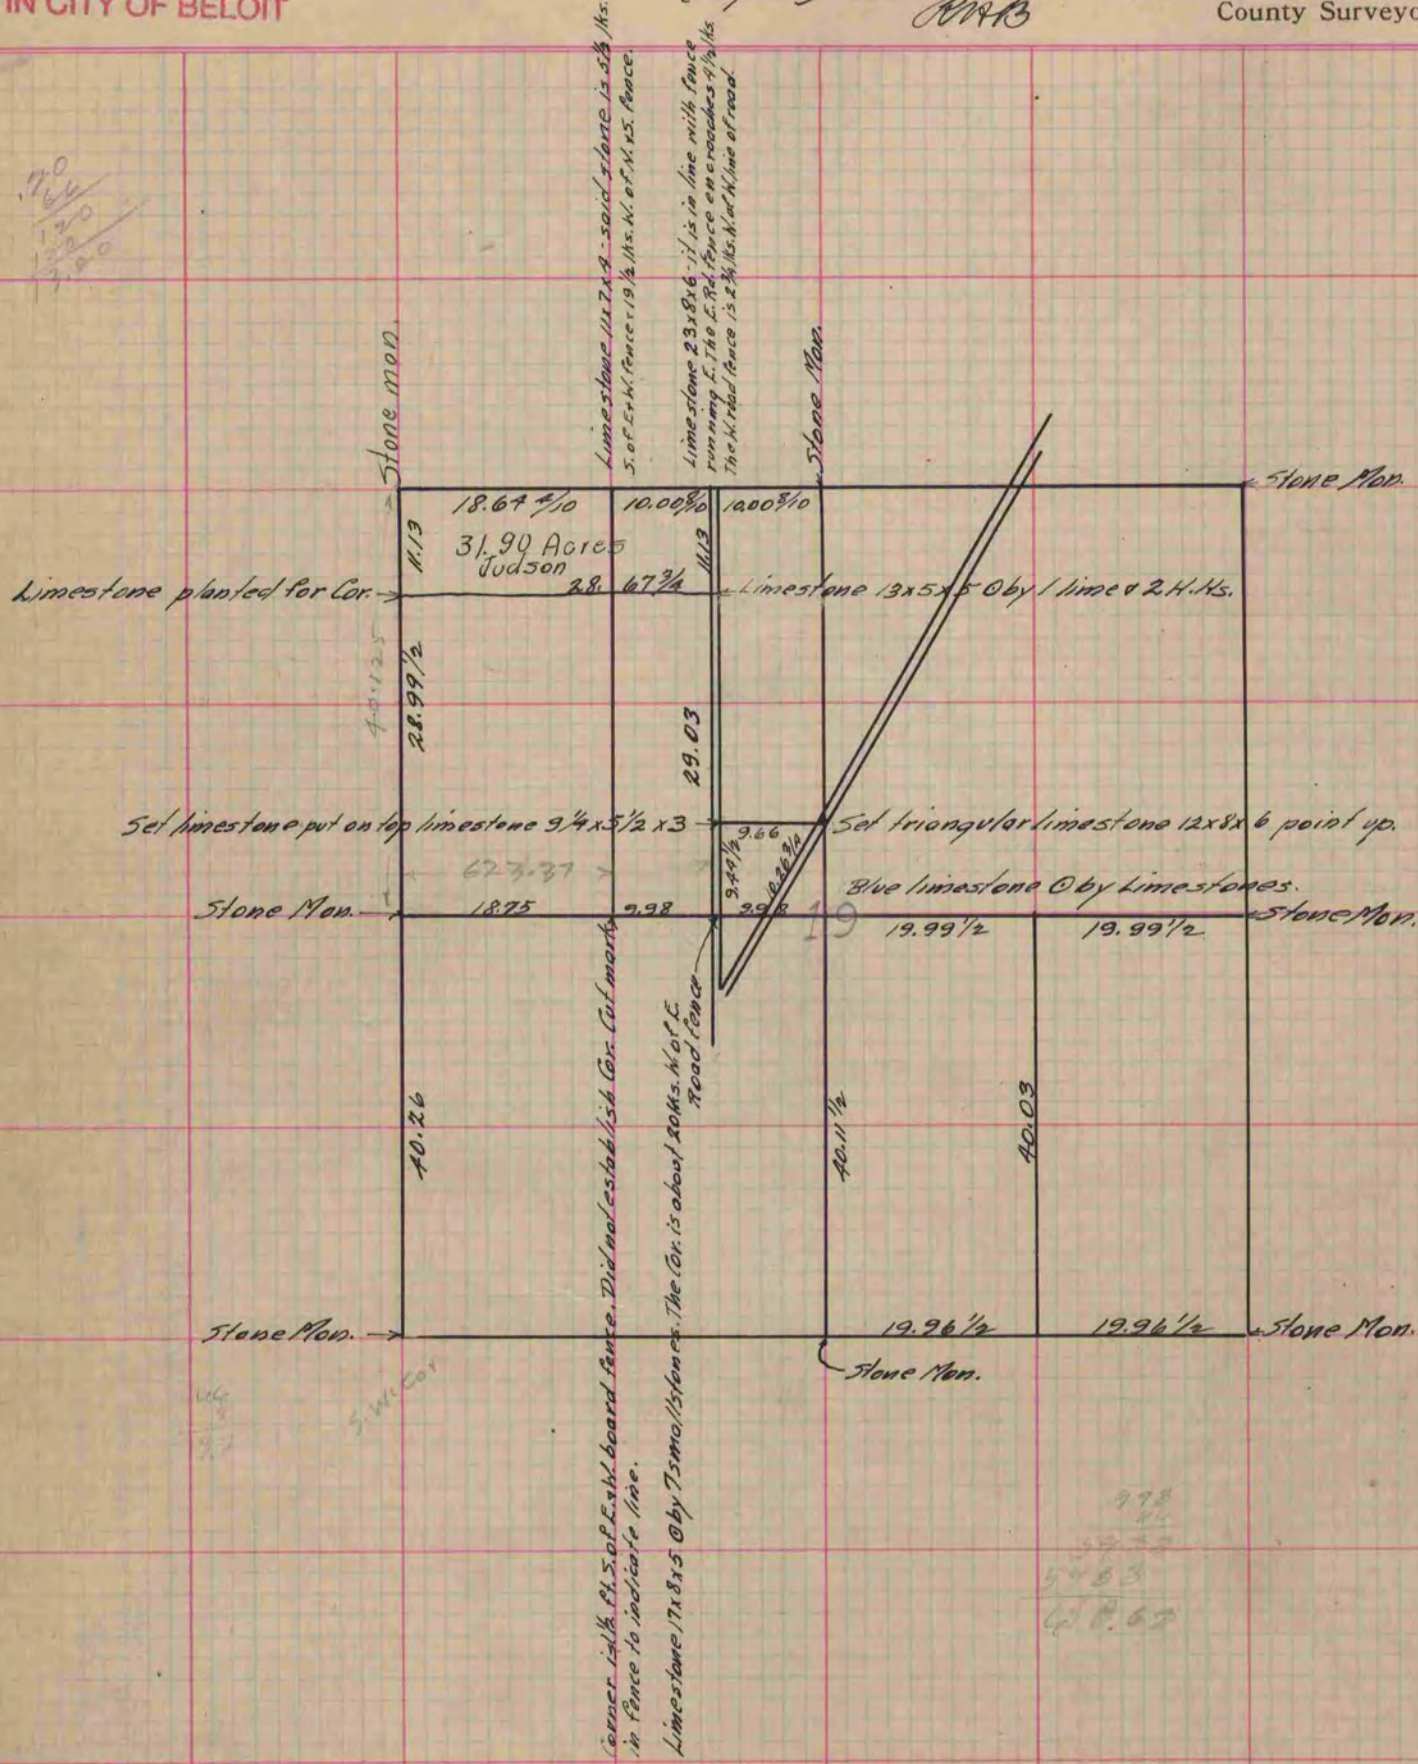

Copied from P. 134 Vol. 2 Original County Surveyors Record.