

# PLAT AND RECORD

Of a Survey on Section 9 T / R 10 E. of the 4 P. M. in Aron Township


Rock County, Wisconsin, made May the 22 + 23 1871

I hereby certify that the following is a correct record of said survey as made by me.

COUNTY BUILDING  
IN CITY OF BELOIT

(Signed) Edward Ruger

County Surveyor.

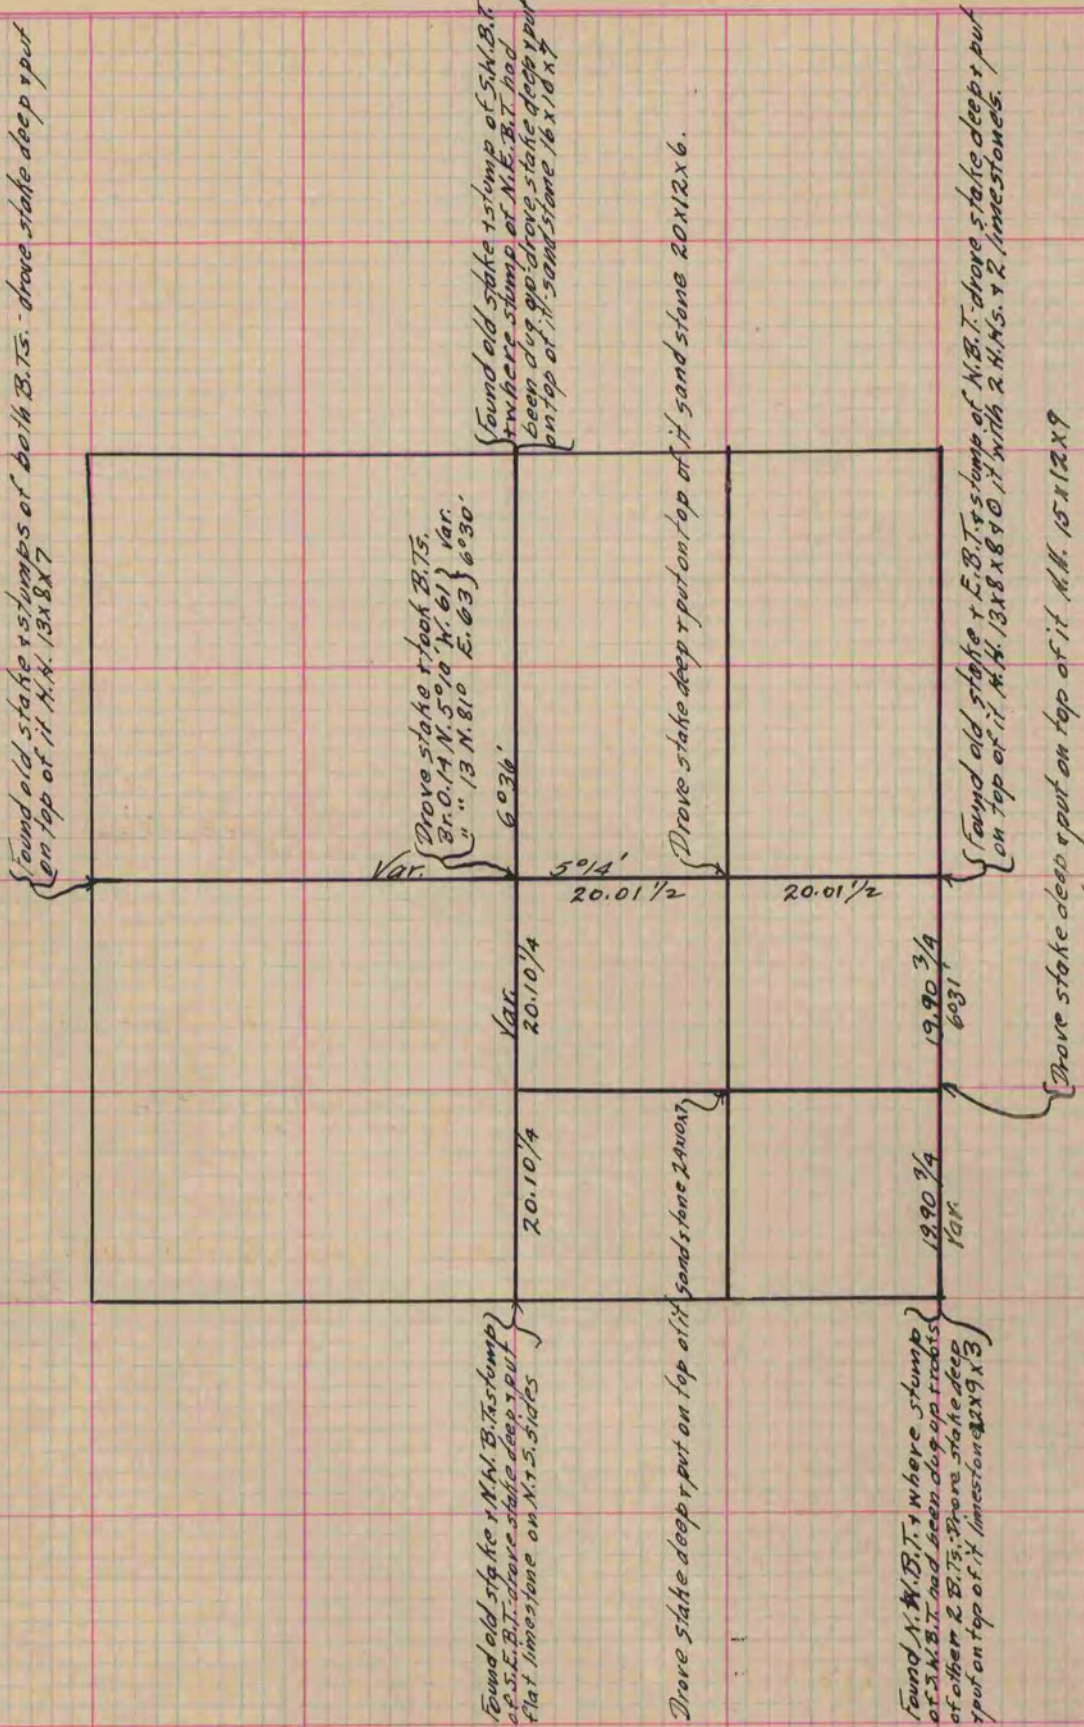

Copied from Page 40 Vol. 2 Original County Surveyor's Record.