

# PLAT AND RECORD

77

Of a Survey on Section 11 T 1 R 14 E. of the 4 P. M. in Clinton Township  
Rock County, Wisconsin, made October the 13 1871


I hereby certify that the following is a correct record of said survey as made by me.

COUNTY BUILDING  
IN CITY OF BELOIT

(Signed) Edward Ruger.

County Surveyor.

See Sec. 2 Clinton Page 45

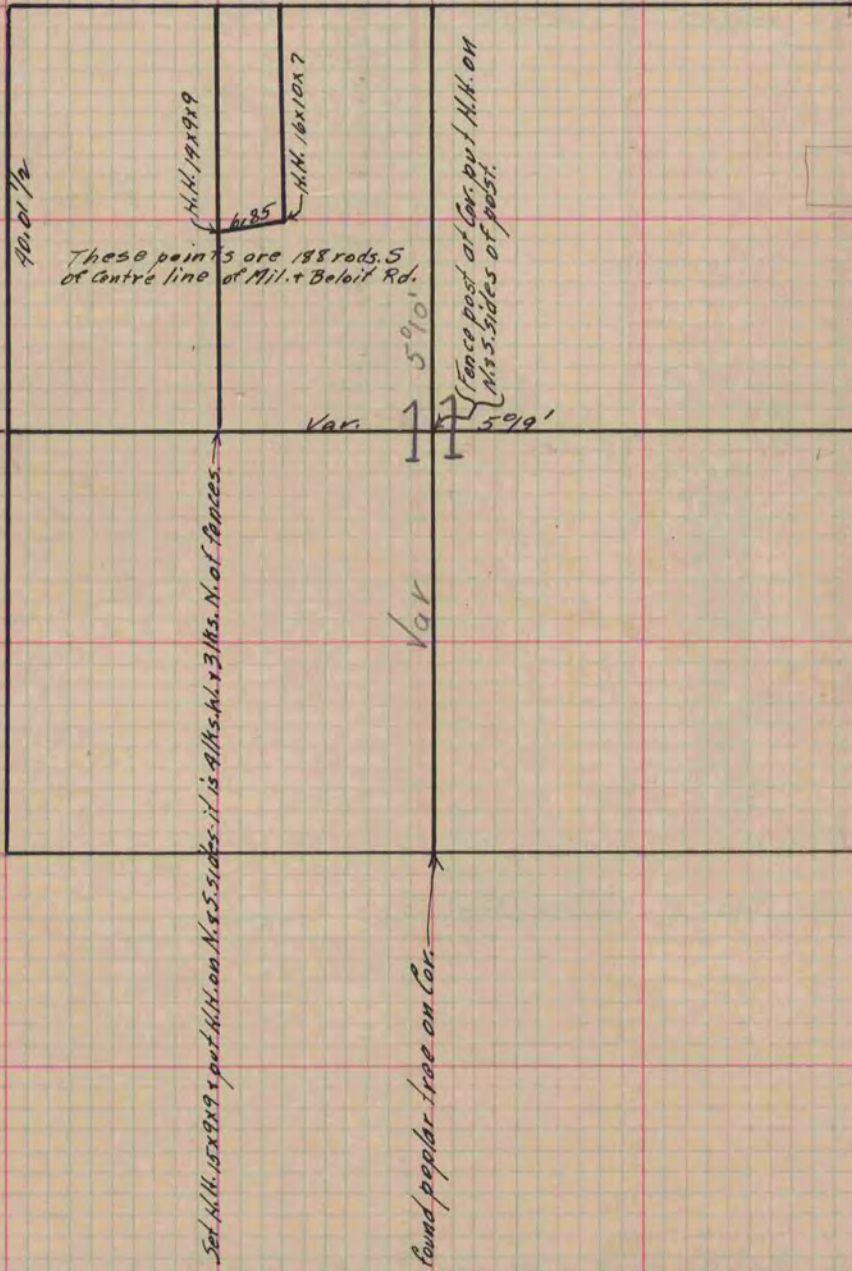

Copied from Page 46 Vol. 2 Original County Surveyor's Record.