

PLAT AND RECORD

Of a Survey on ^{N.W. 1/4} Section 26 T 4 R 10 E. of the 4 P. M. in Union Township


Rock County, Wisconsin, made Dec. the 5 1883

I hereby certify that the following is a correct record of said survey as made by me.

COUNTY BUILDING
IN CITY OF БЕЛОIT

(Signed) Edward Rizer
R.R.S.

Depl.
County Surveyor.

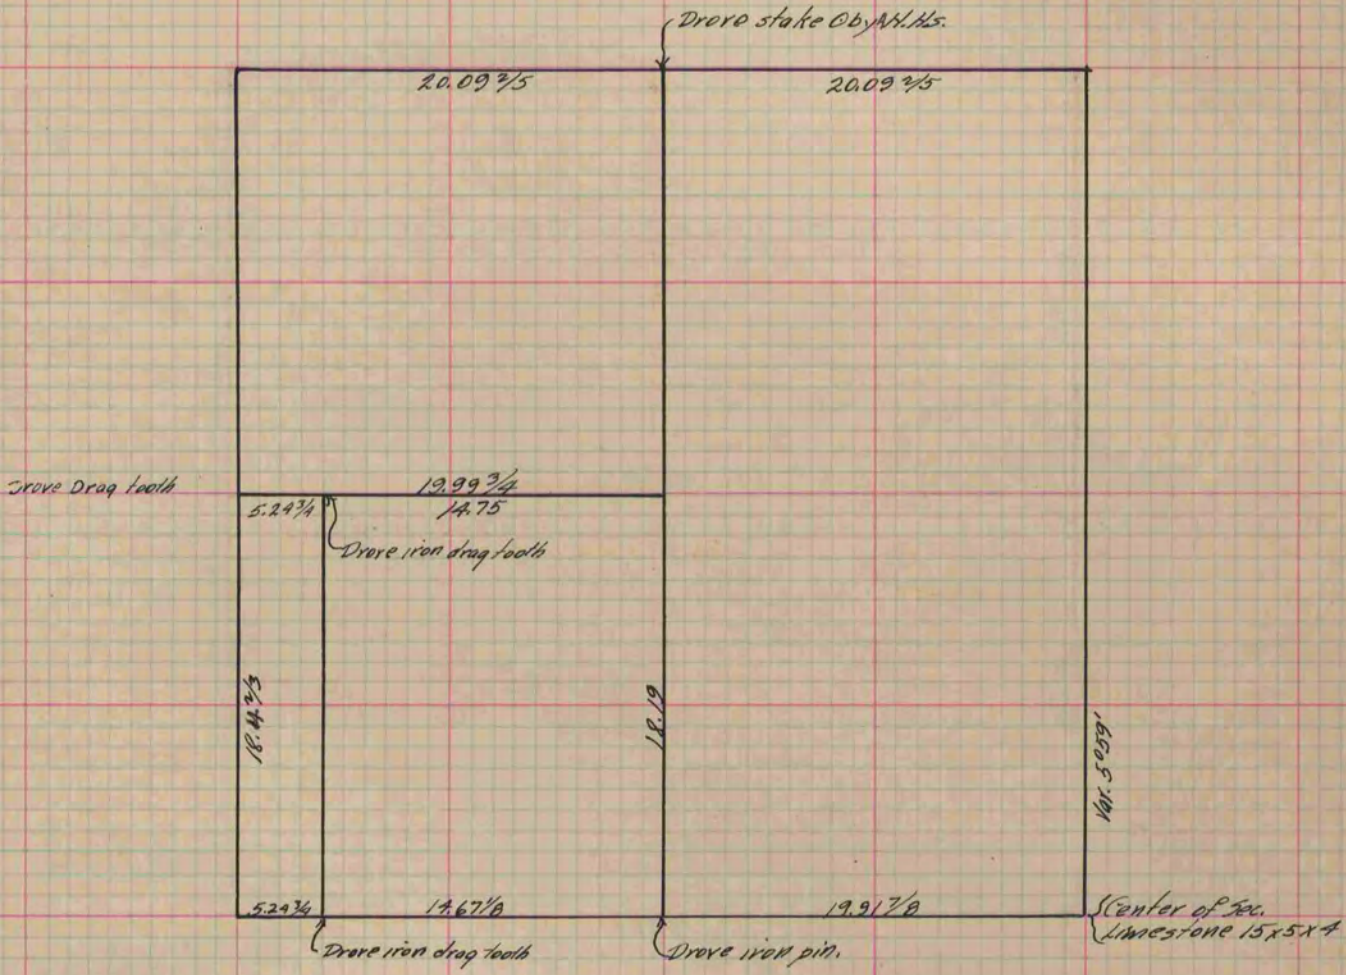

Copied from P. 320 Vol. 2 County Surveyor's Record