

PLAT AND RECORD

175

Of a Survey on Section 20 T 2 R 12 E. of the 4 P. M. in Rock Township

Rock County, Wisconsin, made November the 18th 1874


I hereby certify that the following is a correct record of said survey as made by me.

COUNTY BUILDING
IN CITY OF BELOIT

(Signed) Edward Ruger
N. 11/13

County Surveyor.

The Survey was made to establish the N. + S. Quarter line.
The stakes on the $\frac{1}{4}$ line were not driven to Establish
Corners, but simply to mark the Quarter line.

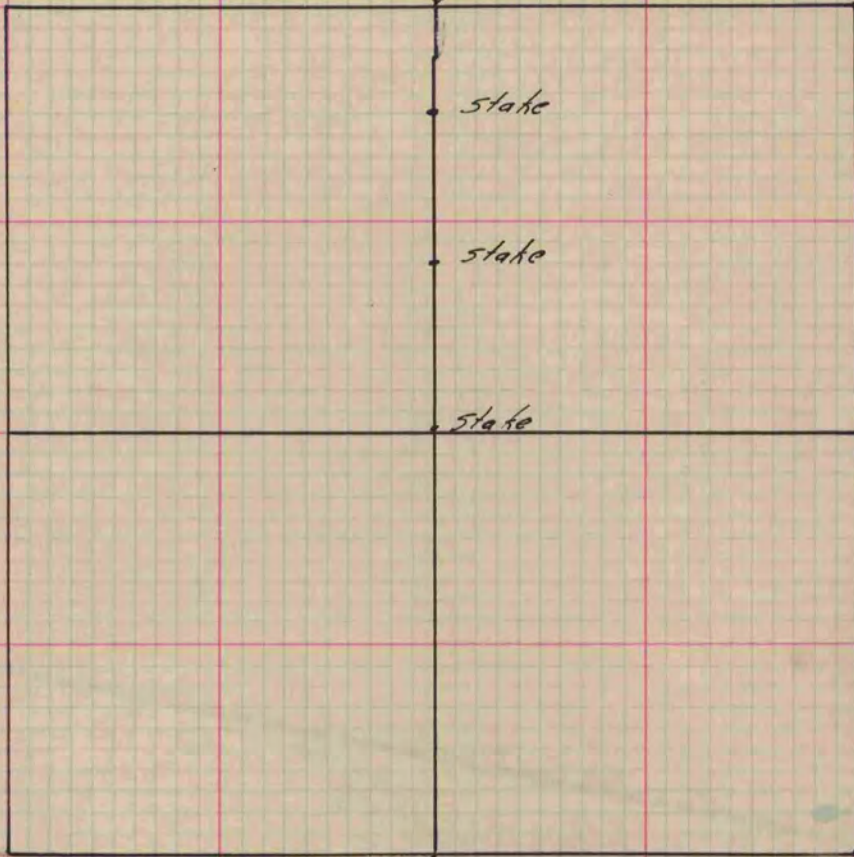

Copied from T. 131 Vol. 2 Original County Surveyor's Records