

PLAT AND RECORD

275


Of a Survey on Section 24 T 3 R 13 E. of the 4 P. M. in Harmony Township
Rock County, Wisconsin, made December the 7th 1866

I hereby certify that the following is a correct record of said survey as made by me.

COUNTY BUILDING
IN CITY OF BELOIT

(Signed) S.D. Locke
S.D.L.

County Surveyor.

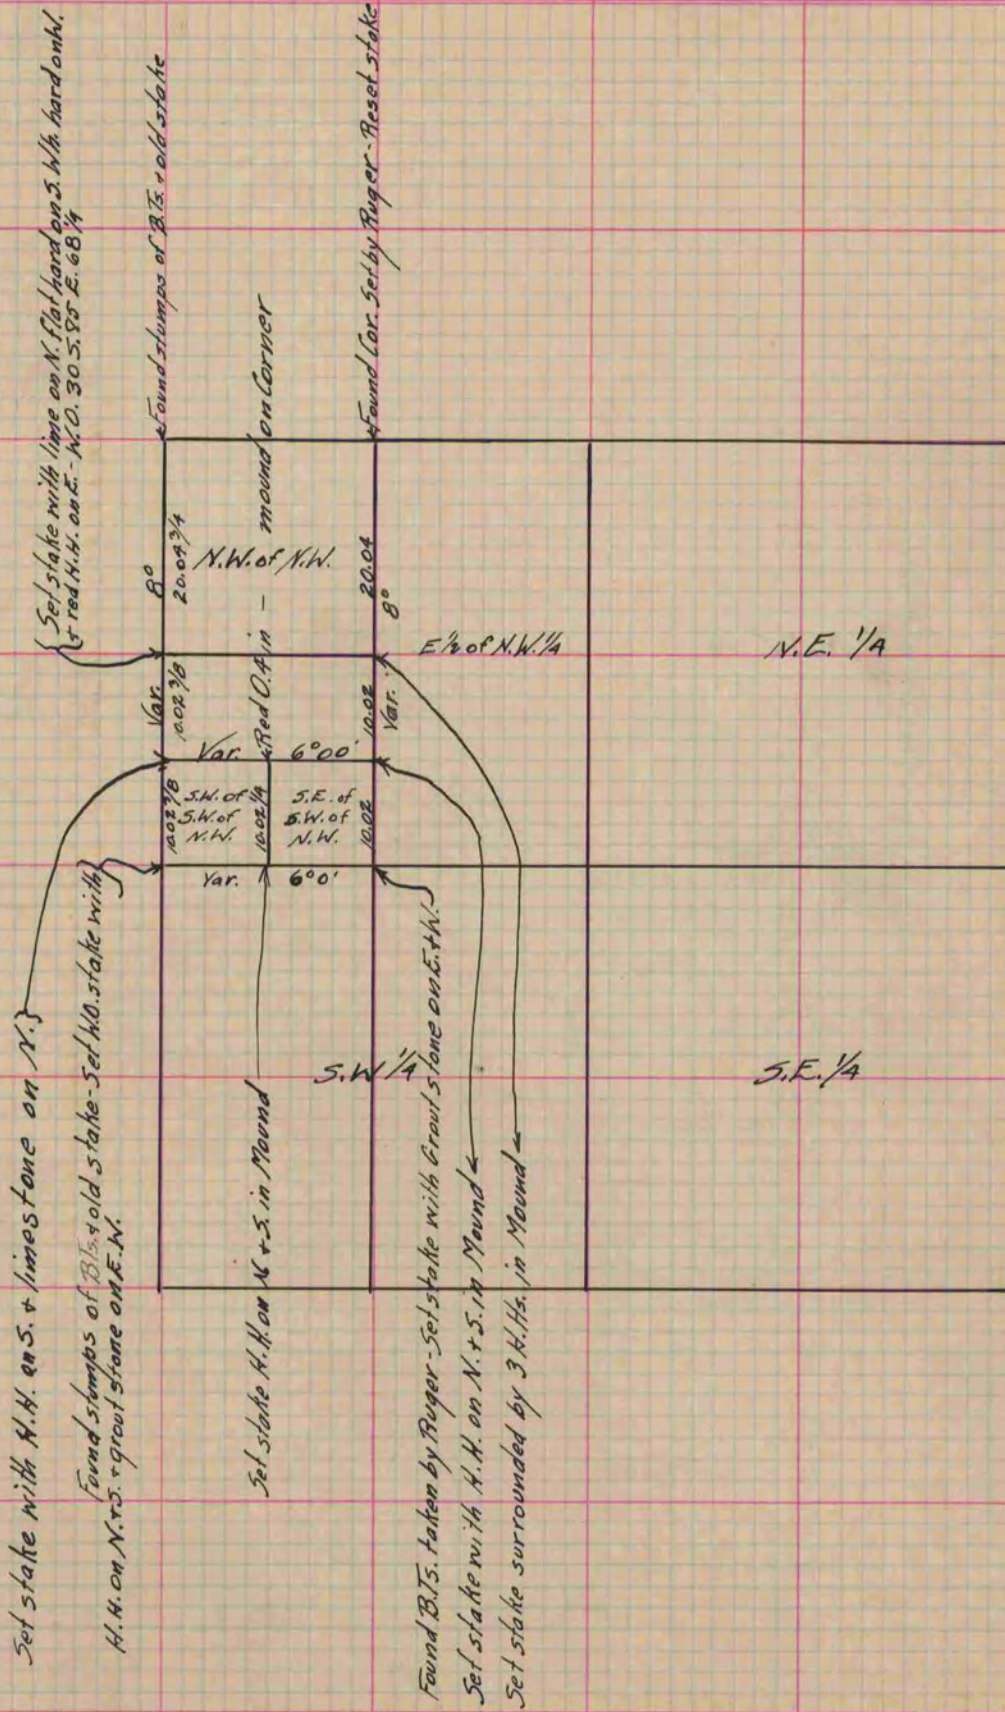

Copied from Page 2A1 Vol. 1. Original County Surveyor's Record.