

PLAT AND RECORD

Of a Survey on Section 15 T 3 R 10 E. of the 4 P. M. in Magnolia Township


Rock County, Wisconsin, made January the 12 + 13 1871

I hereby certify that the following is a correct record of said survey as made by me.

COUNTY BUILDING
IN CITY OF BELOIT

(Signed) Edward Ruger

County Surveyor.

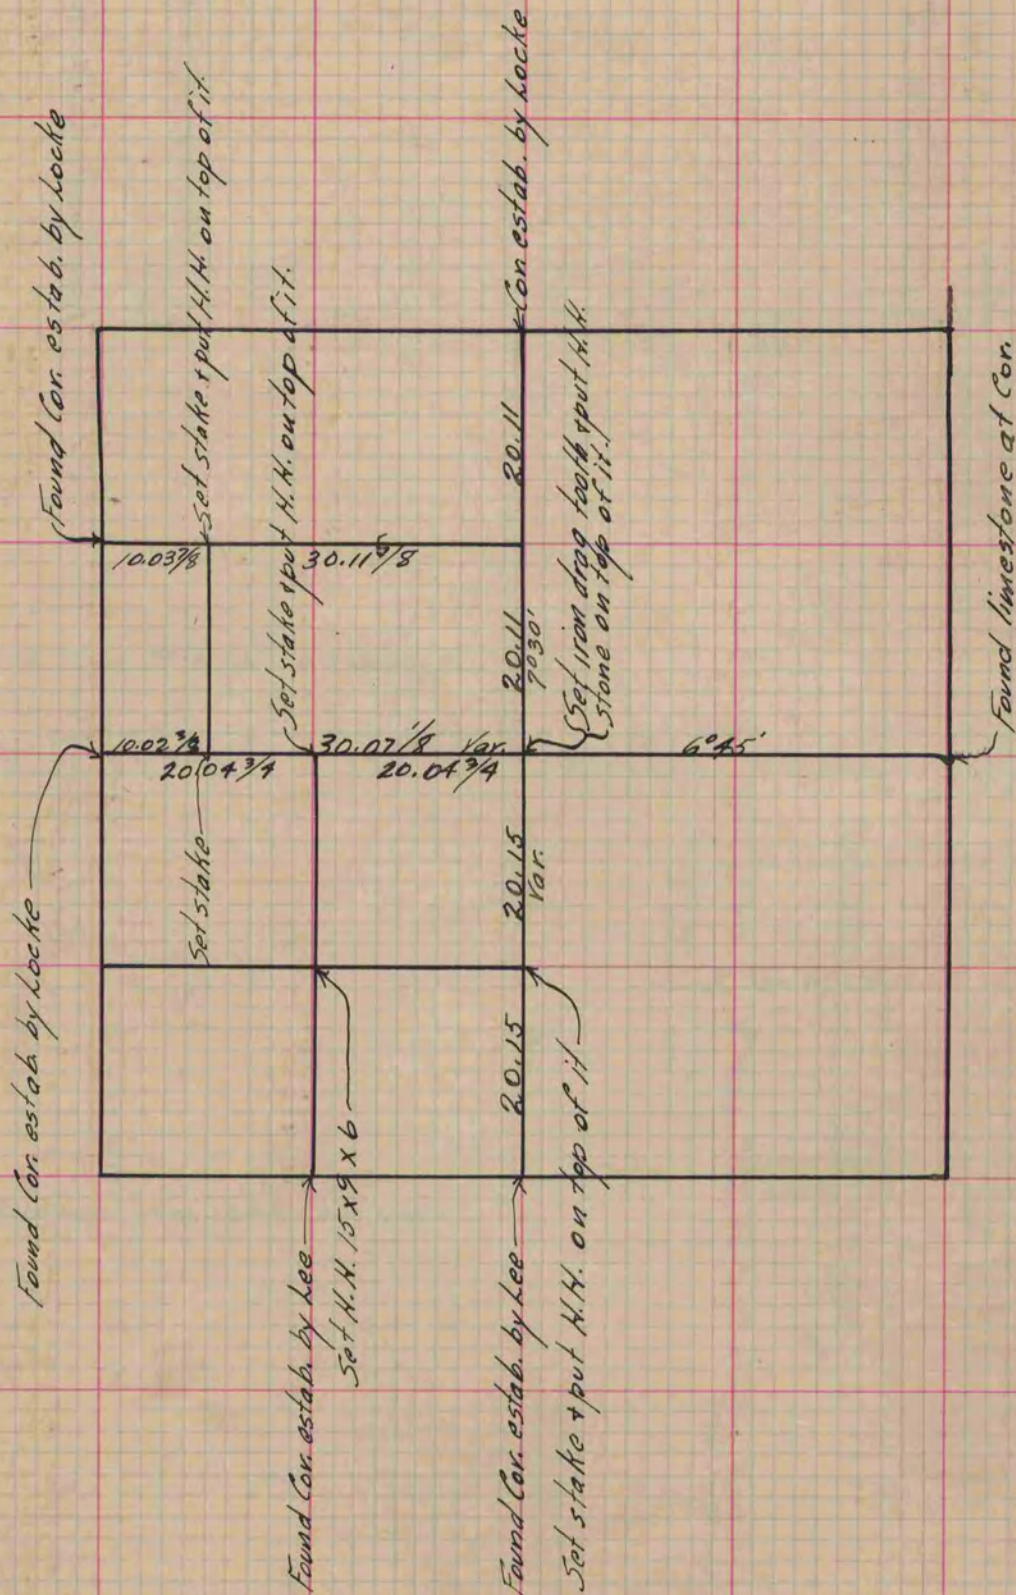

Copied from Lower 1/2 of Page 33 Vol. 2. Original County Surveyors Record.