

PLAT AND RECORD


Of a Survey on Section 4 T 2 R 10 E. of the 4 P. M. in Spring Valley Township
 Rock County, Wisconsin, made June the 5th 1855

I hereby certify that the following is a correct record of said survey as made by me.

COUNTY BUILDING
 IN CITY OF BELOIT

(Signed) Joseph Church
J. Church

County Surveyor.

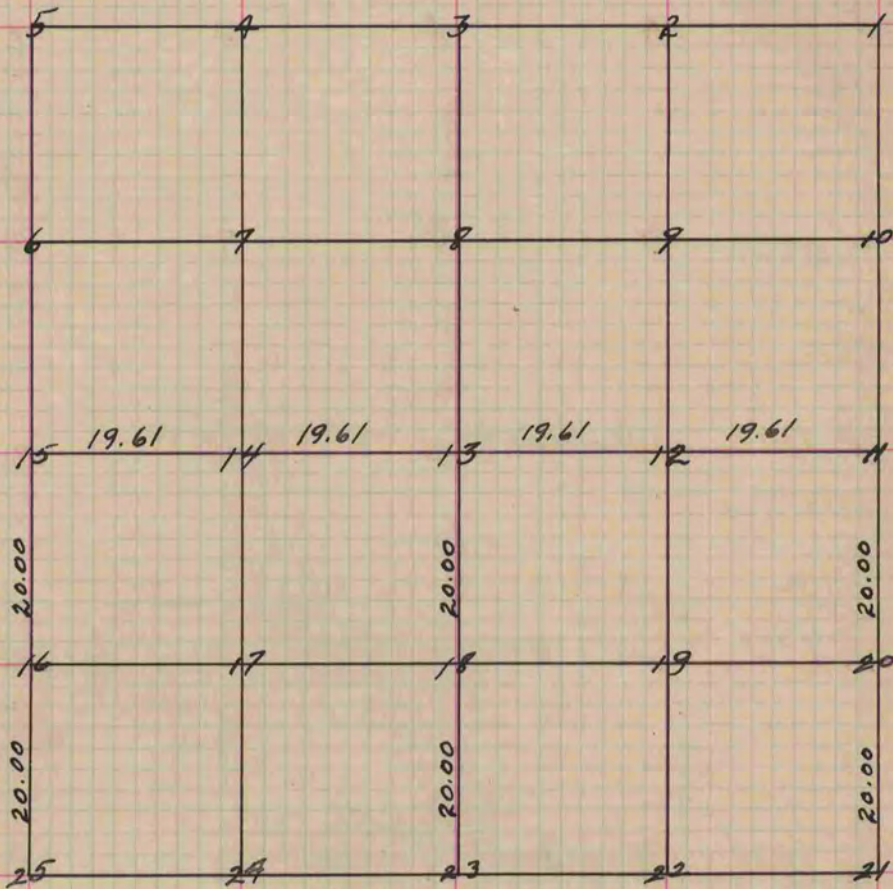

- Fig. 21 S.E. Corner of a well N. $\frac{1}{2}$ W 102 links.
 S.W. " of a storehouse S. $68\frac{1}{4}$ D.W. 200 links.
- Fig. 12 Burr Oak S. $65\frac{1}{4}$ W. 57 links.
 " " S. $69\frac{1}{2}$ E. 56 links.
- Fig. 13 Black Oak 14 N. 54 W. 667 links.
 Bur Oak 14 S. $5\frac{1}{2}$ E. 121 "
- Fig. 23 the Government Survey is N. 46 E. 89 from where it should be.
 Bur. Oak 20 S. $29\frac{1}{2}$ E. $34\frac{1}{2}$ links.
 20 N. 14 W. 78

Copied from Page 42 Vol. 1 Original County Surveyors Record.