

PLAT AND RECORD

Of a Survey on Section 3 T. 1 R. 12 E. of the 4 P. M. in Beloit Township
 Rock County, Wisconsin, made June the 11th 1858

I hereby certify that the following is a correct record of said survey as made by me.

COUNTY BUILDING
 IN CITY OF БЕЛОIT

(Signed) Joseph Church
JMC

County Surveyor.

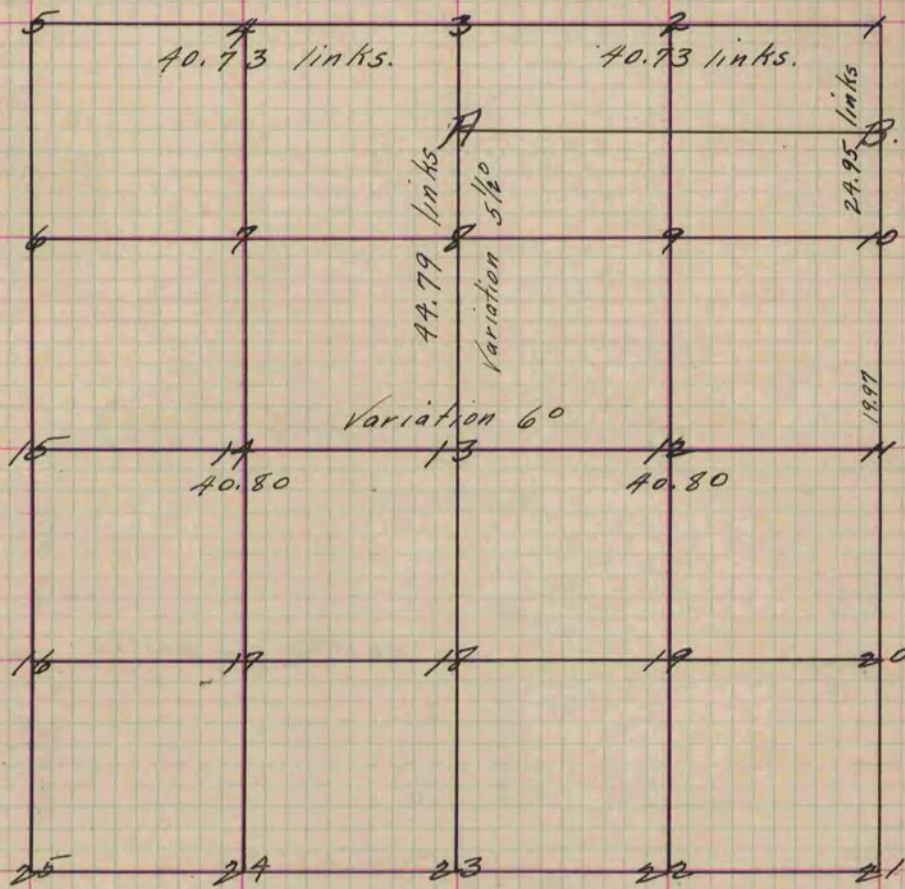


Fig. 12 Stake Marked. No bearings.
 " 18 " " " "
 " 11 " " " "
 letters A & B Stake marked no bearings.

Copied from Page 82 Vol. One, Original County Surveyor's Record.