

# PLAT AND RECORD

Of a Survey on Section 1 T 3 R 14 E. of the 4 P. M. in Johnstown Township  
Rock County, Wisconsin, made February the 19<sup>th</sup> 1852

I hereby certify that the following is a correct record of said survey as made by me.

COUNTY BUILDING  
IN CITY OF БЕЛОIT

(Signed) Peter McVean  
R. H. B. County Surveyor.

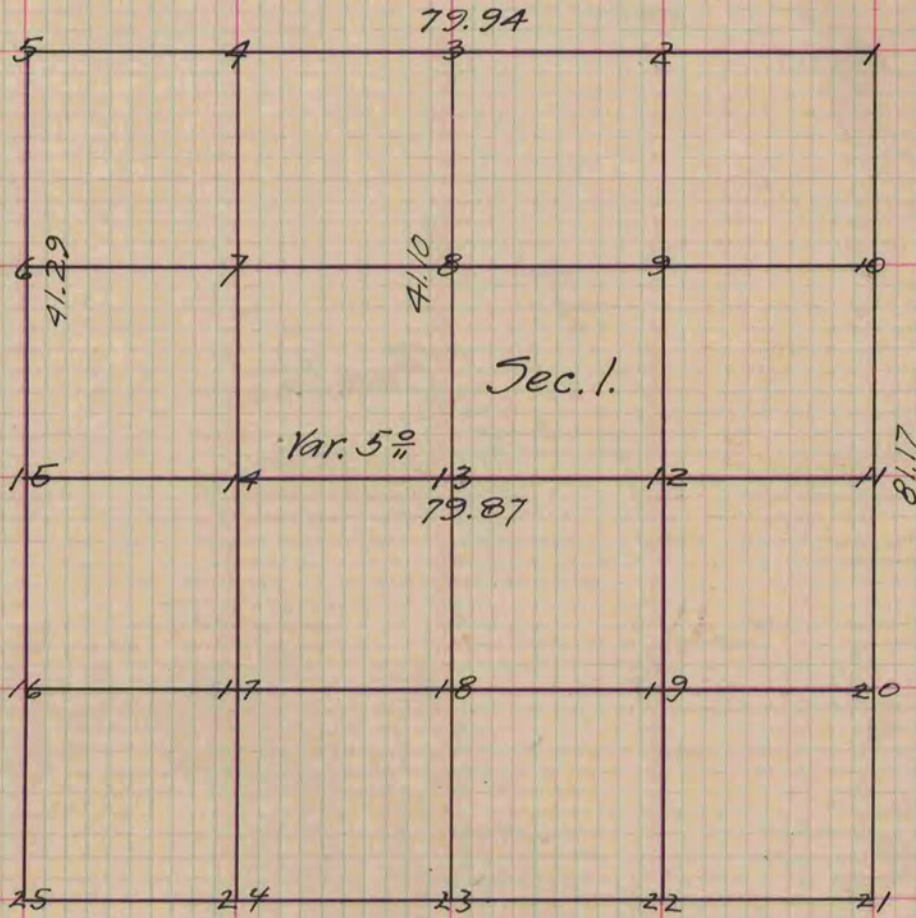


Figure 13 represents the centre of the Section  
Fig. 13 Br. O. 14 West 10 Also Br. O. 10 N. 63 W. 37

Copied from Page 12 Vol. 1. Original County Surveyors Record