

PLAT AND RECORD

Of a Survey on Section 5 T 1 R 13 E. of the 4 P. M. in Turtle Township
Rock County, Wisconsin, made May the 16th 1853

I hereby certify that the following is a correct record of said survey as made by me.

COUNTY BUILDING
IN CITY OF БЕЛОIT

(Signed) Peter McVean
R.H.B. County Surveyor.

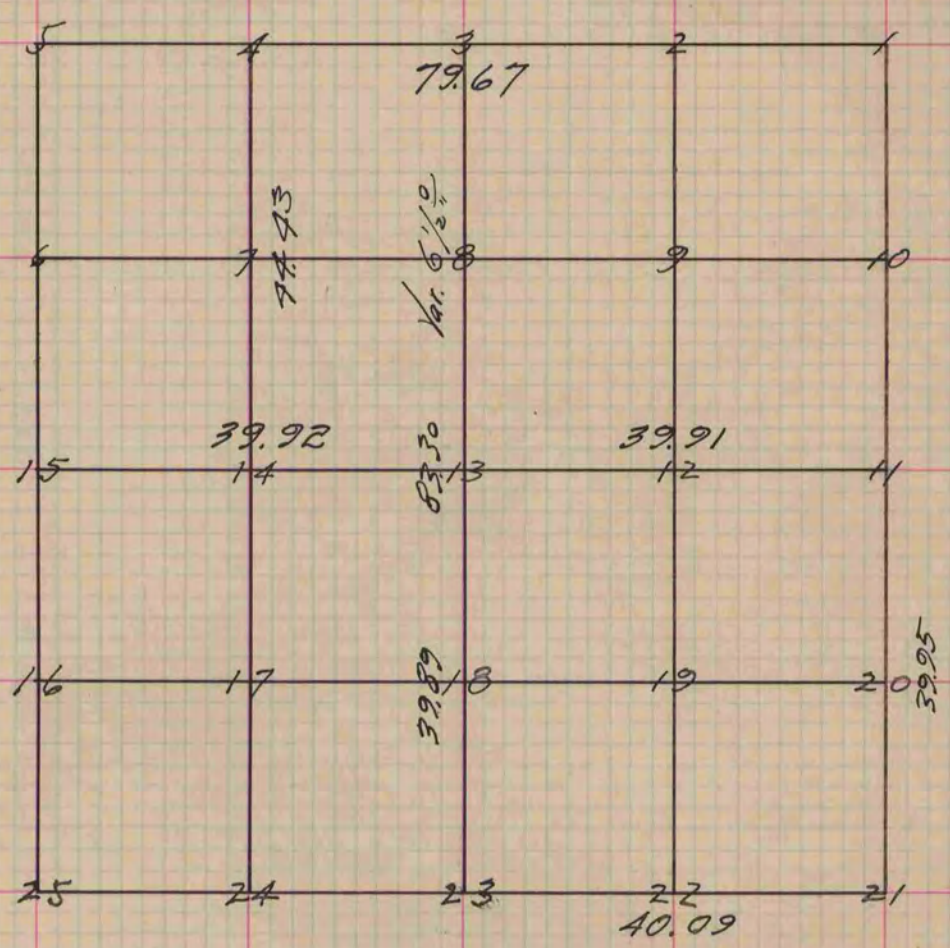


Figure 13 represents the centre of the Section
Figure 13. Burried a stone 15 inches long 10 wide 5 thick and even
with the surface of the ground.
Fig. 12. Burried a stone 18 inches in sod fence

Copied from page 20 Vol. 1 Original County Surveyors Record