

PLAT AND RECORD

Of a Survey on Section ^(Not Given) _{52 in pencil} 3 R. 11 E. of the 4 P. M. in Centre Township
 Rock County, Wisconsin, made February the 22nd 1853

I hereby certify that the following is a correct record of said survey as made by me.

COUNTY BUILDING
 IN CITY OF BELOIT

(Signed) Peter McVean
 R.H.B. County Surveyor.

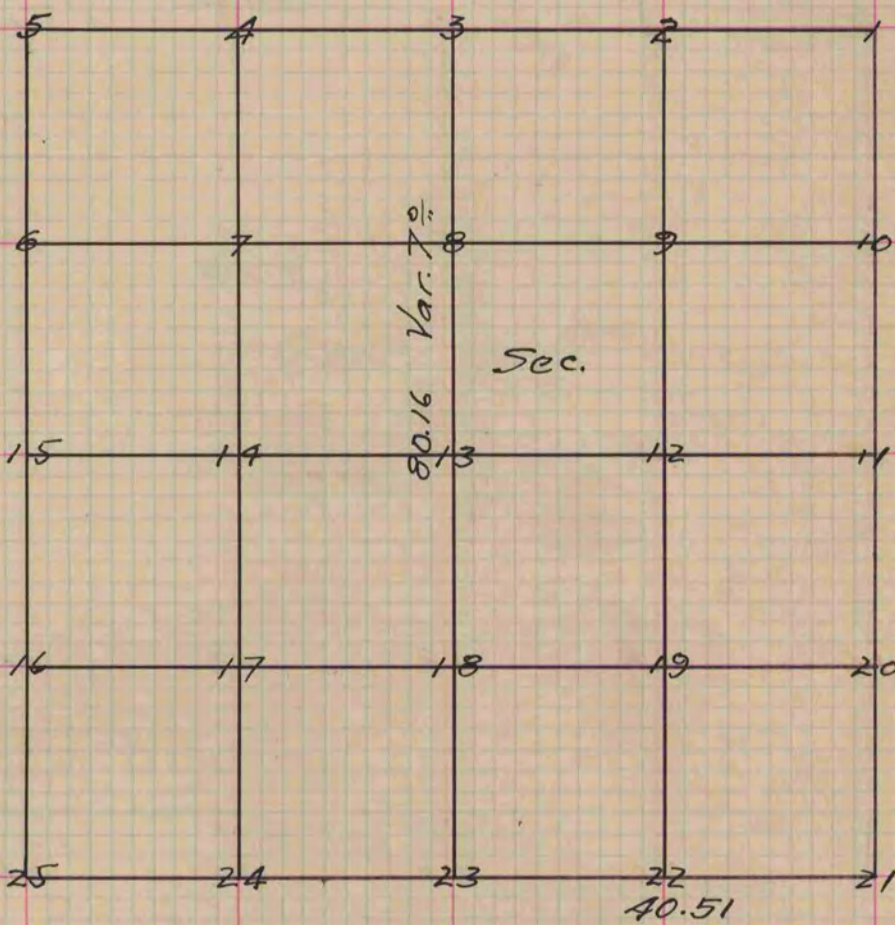


Figure 13 represents the centre of the Section
 Fig. 13. W.O. 14 S. 25 W. 76 Also W.O. 8 S. 74 E. 76
 " 24 Br. O. 9 S. 34 E. 70 Also Br. O. 14 S. 31 W. 79
 " 12 Post in Grubs

Copied from page 16 Vol. 1. Original County Surveyors Record