


PLAT AND RECORD

Of a Survey on Section 31 T 3 R 13 E. of the 4 P. M. in Harmony Township
 Rock County, Wisconsin, made April the 3rd & 4th 1871

I hereby certify that the following is a correct record of said survey as made by me.

COUNTY BUILDING
 IN CITY OF BELOIT

(Signed) Edward Ruger
 County Surveyor.

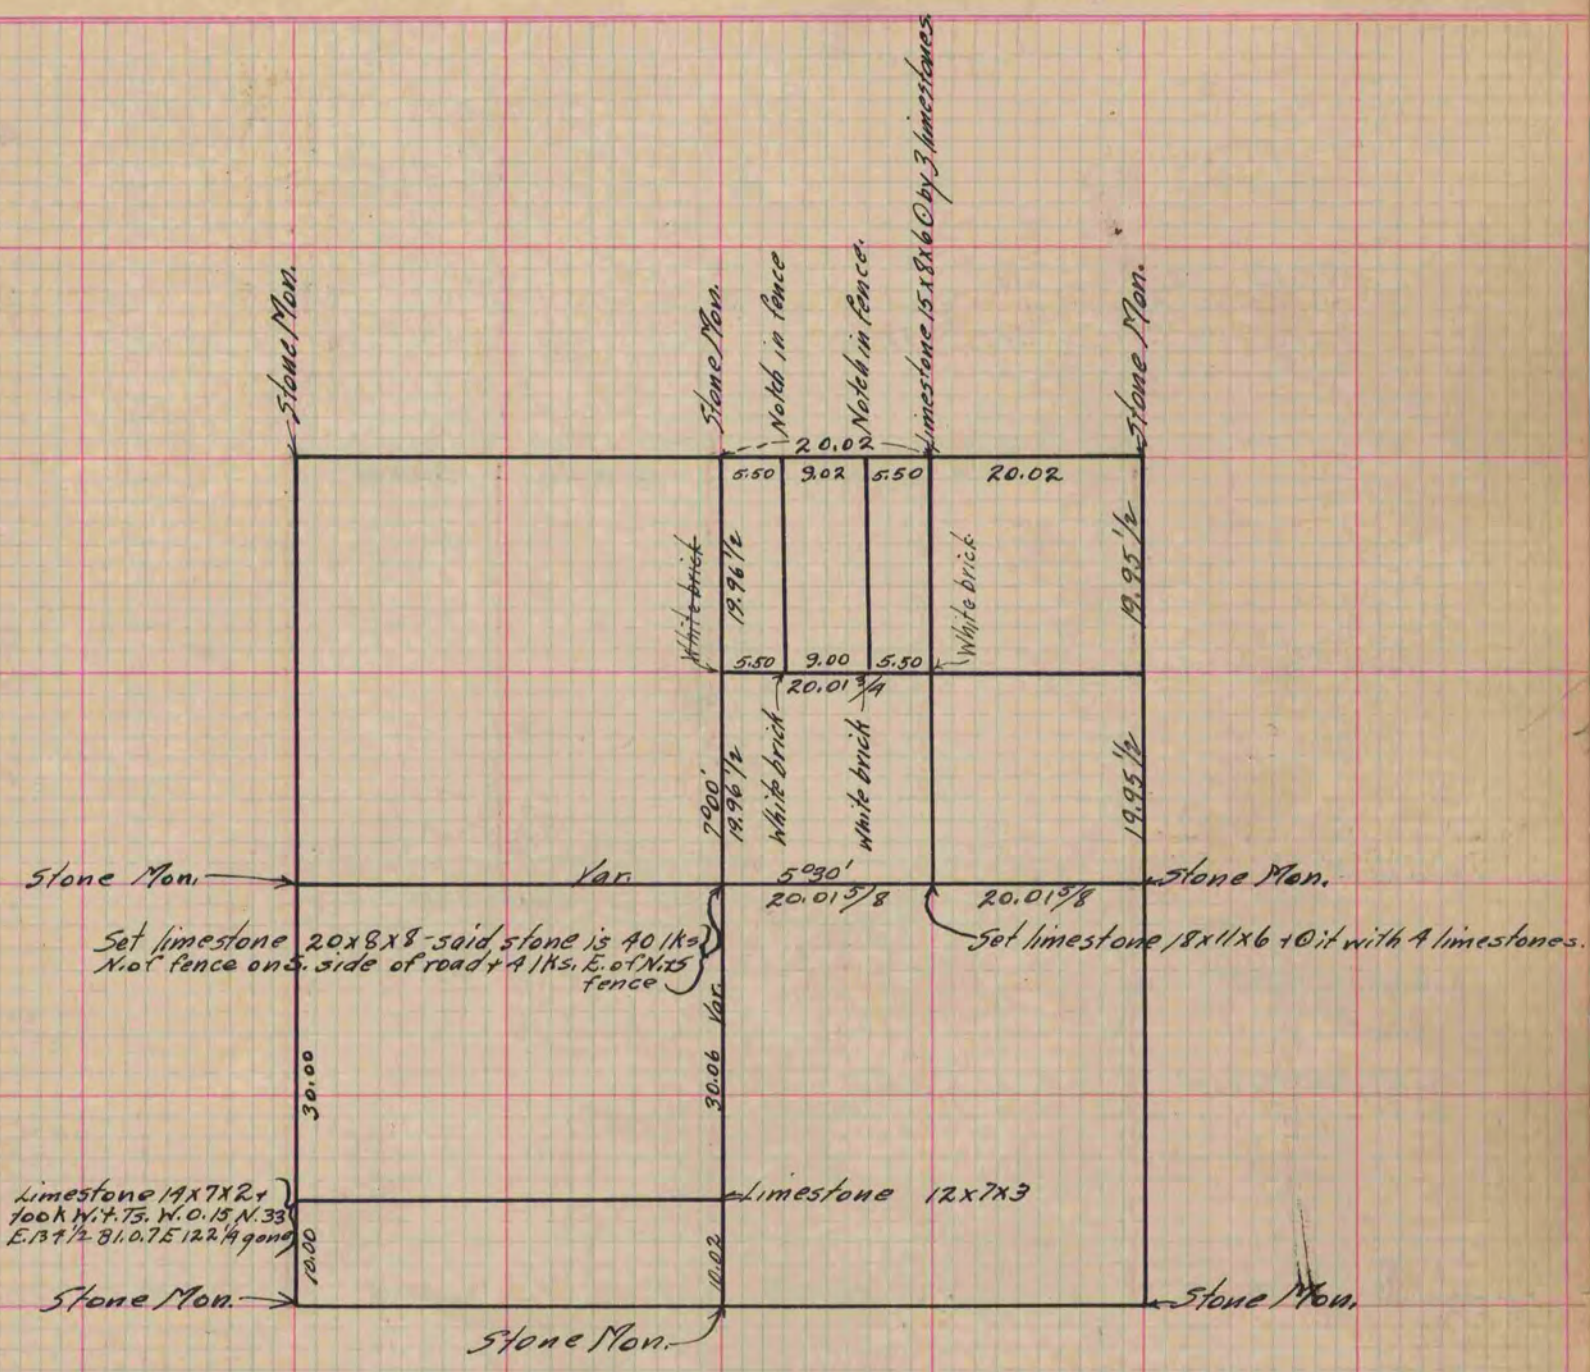

Copied from Page 37 Vol. 2 Original County Surveyor's Record.