

PLAT AND RECORD


Of a Survey on Section 5 T 3 R 13 E. of the 4 P. M. in Harmony Township
 Rock County, Wisconsin, made June the 5th 1872

I hereby certify that the following is a correct record of said survey as made by me.

COUNTY BUILDING
 IN CITY OF BELOIT

(Signed) R. K. Lee
RKL

County Surveyor.

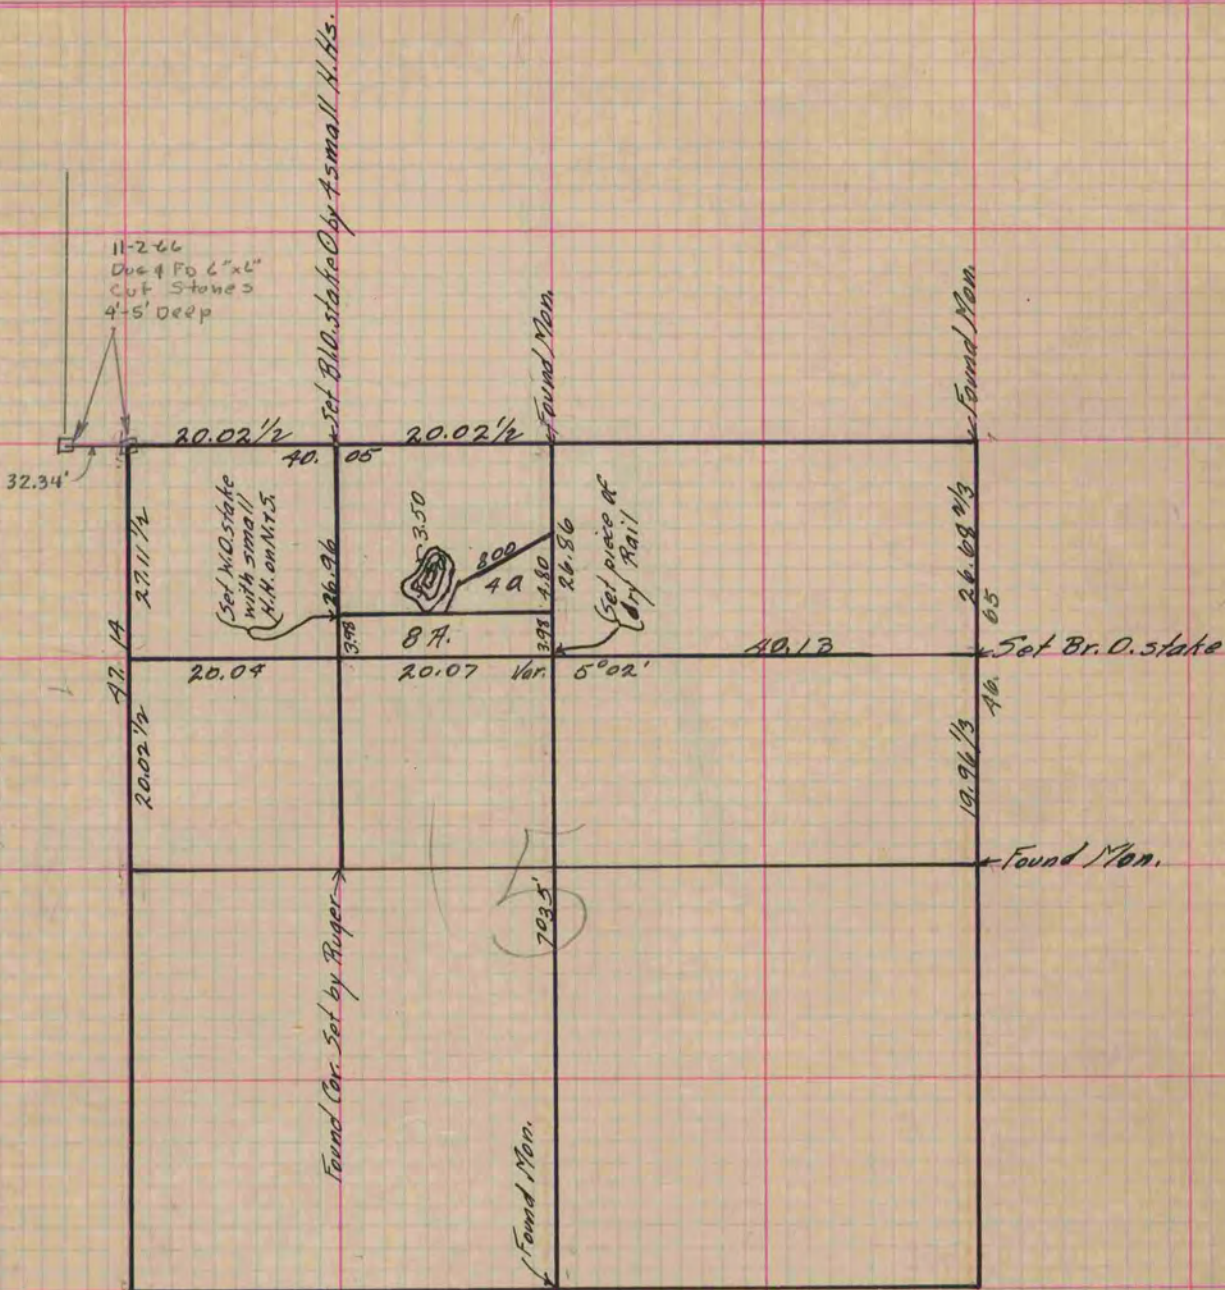

Copied from Upper 1/2 Page 52 Vol. 2 Original County Surveyor's Record.