

PLAT AND RECORD

Of a Survey on Section 8 T 4 R 12 E. of the 4 P. M. in Fulton Township


Rock County, Wisconsin, made March the 31st + April 13 1871

I hereby certify that the following is a correct record of said survey as made by me.

COUNTY BUILDING
IN CITY OF BELOIT

(Signed) Edward Ruger
R.R.B.

County Surveyor.

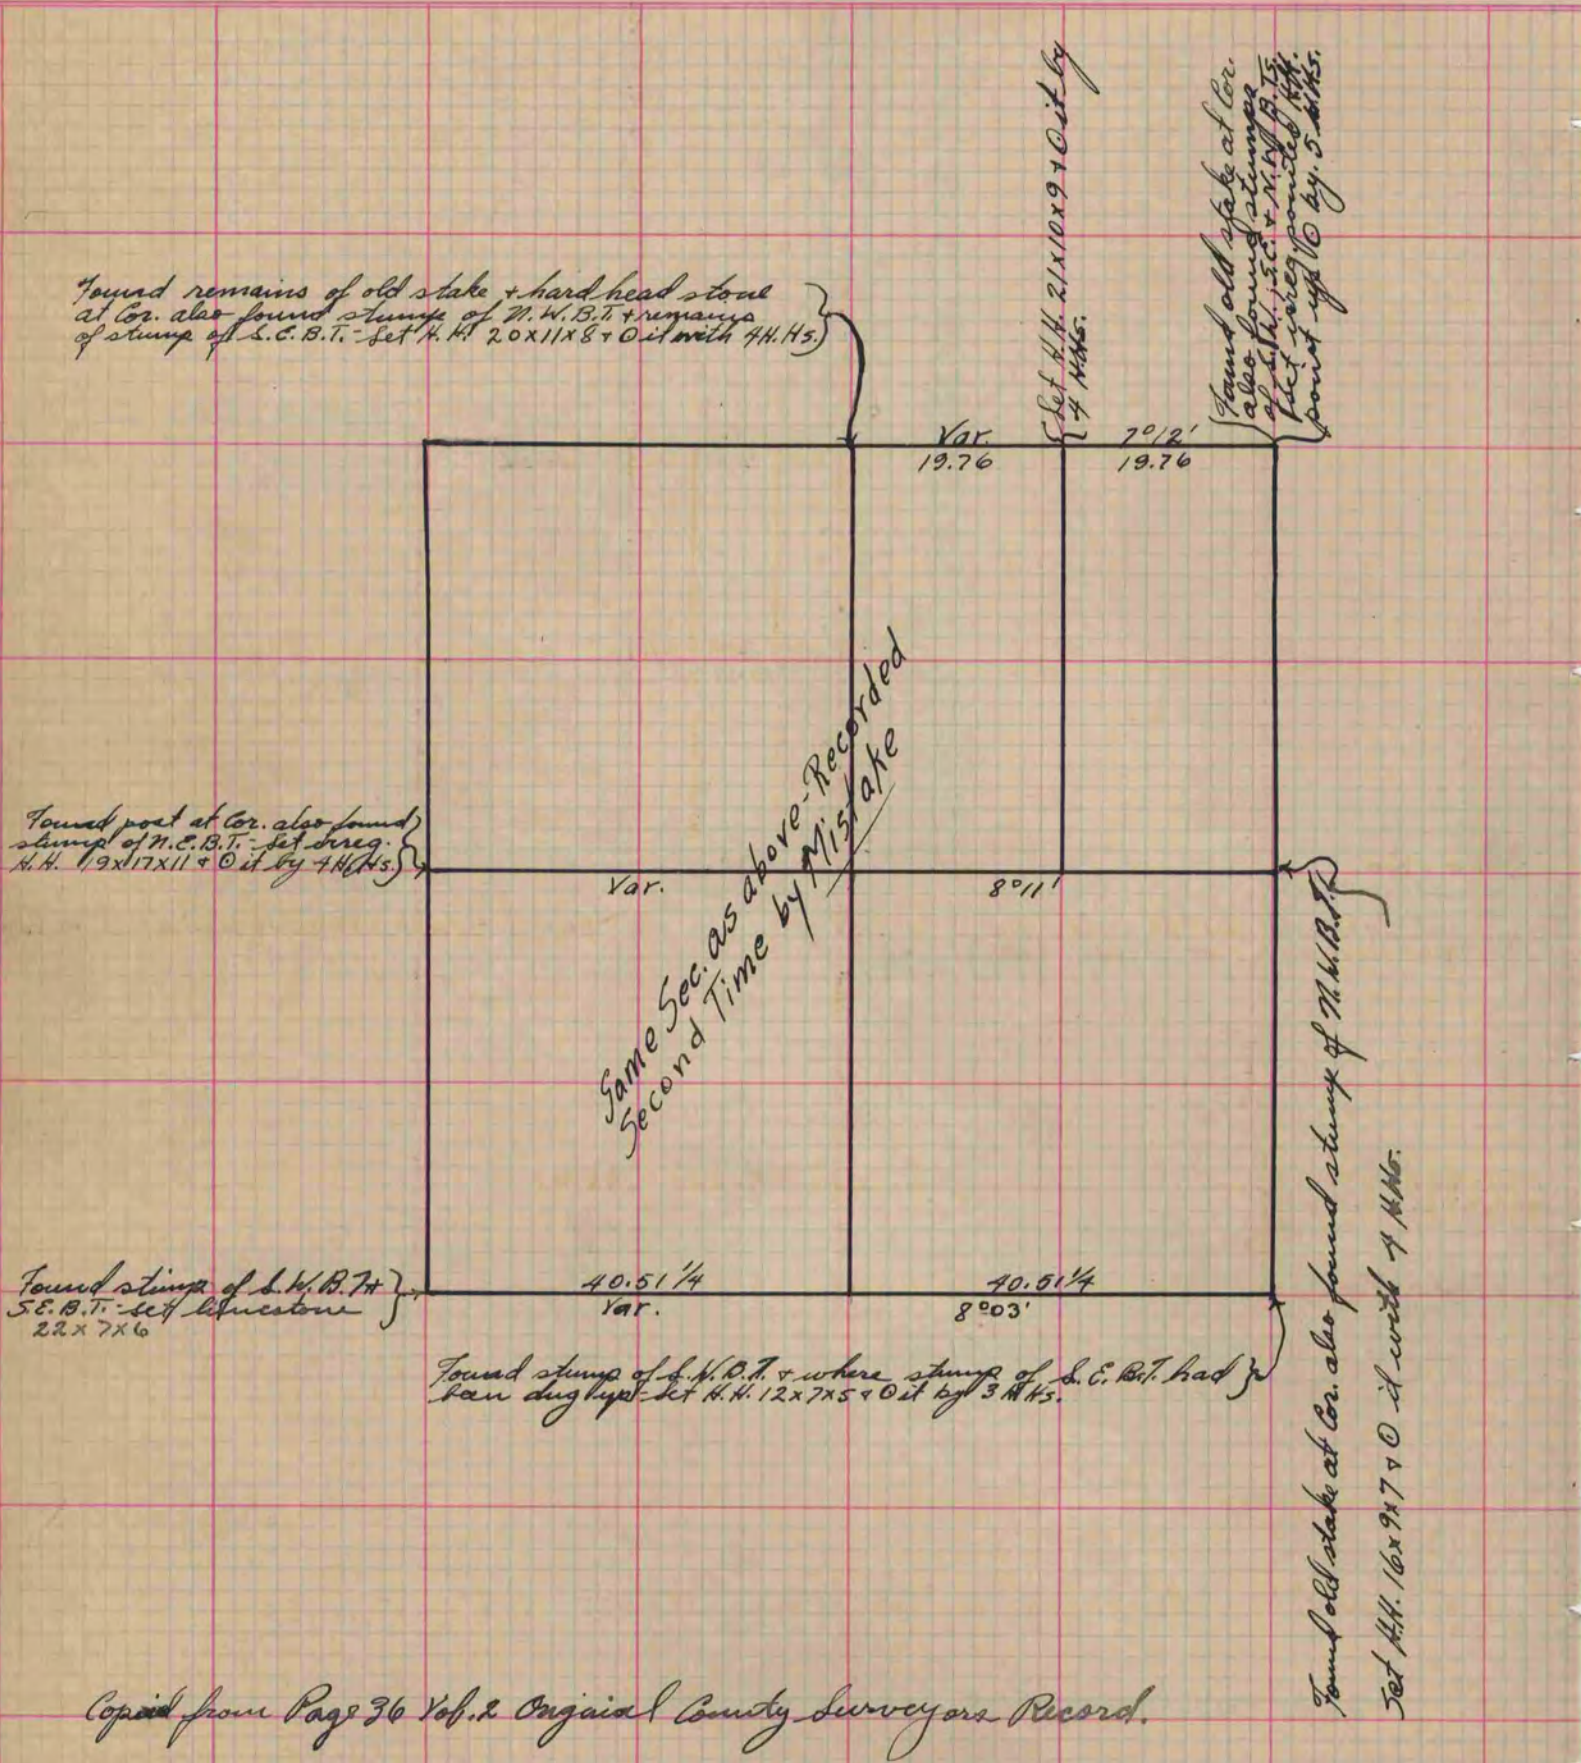

Copied from Page 36 Vol. 2 Original County Surveyors Record.