

PLAT AND RECORD

Of a Survey on Section 15 T 1 R 14 E. of the 4 P. M. in Clinton Township
Rock County, Wisconsin, made September the 21st 1855

I hereby certify that the following is a correct record of said survey as made by me.

COUNTY BUILDING
IN CITY OF БЕЛОIT

(Signed) Joseph Church
J. H. S. County Surveyor.

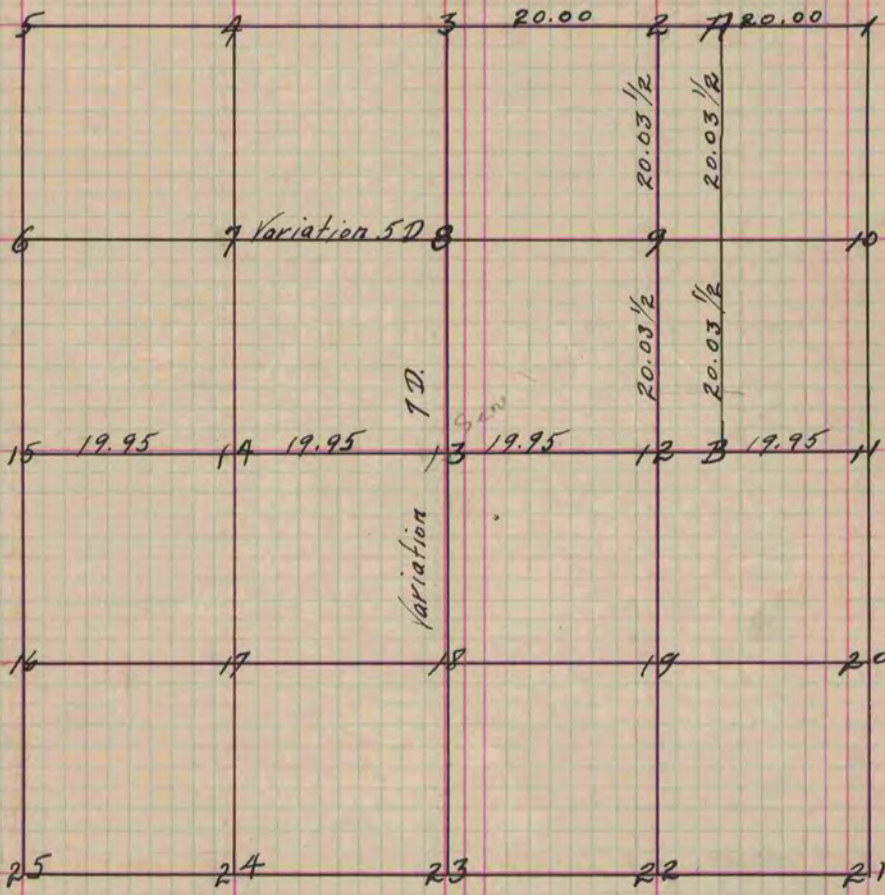


Fig. 2-9-12 & 13 Stakes and Stones
Letters A & B Stake and Stones A is 5 chains from Fig. 2.
B. is 5 chains from Fig. 12

Copied from Page 53 Vol. 1. Original County Surveyors Record.