

PLAT AND RECORD

21

Of a Survey on Section 18 T 1 R 11 E. of the 4 P. M. in NEWARK Township
Rock County, Wisconsin, made OCTOBER the 4th 1974

I hereby certify that the following is a correct record of said survey as made by me.

COUNTY BUILDING
IN CITY OF БЕЛОIT

Hugh J. See
County Surveyor.


THE G. D. BARNARD COMPANY, ST. LOUIS



SEE VOL. 4 PAGE 438

AT W1/4 SEC. 18 FD.
CUT STONE MONUMENT
10-10-74 M.L. J.L. W.K.

SEE VOL. 4 PAGE 438

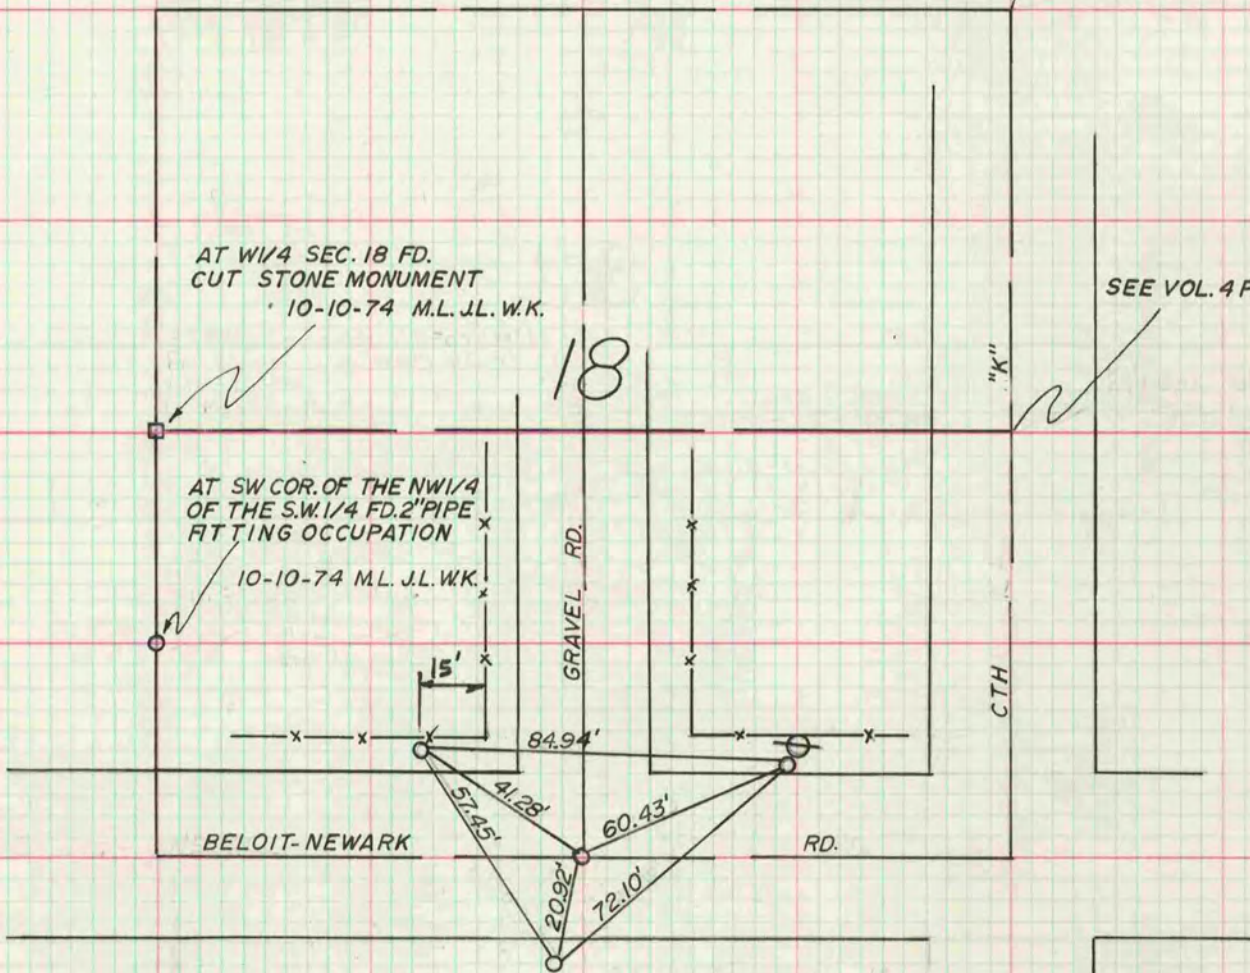

AT S1/4 COR. SEC. 18 FD. PIPE OVER
CUT STONE 10-4-74 J.L. W.K.
REFERENCED 10-8-74 M.L. J.L.

BOOK 176 PG. 23