

PLAT AND RECORD


Of a Survey on Section 24 T 2 R 12 E. of the 4 P. M. in Rock Township

Rock County, Wisconsin, made May the 18 1885

I hereby certify that the following is a correct record of said survey as made by me.
**COUNTY BUILDING
IN CITY OF БЕЛОIT**

(Signed) Edward Ruger.
E.A.R.

County Surveyor.

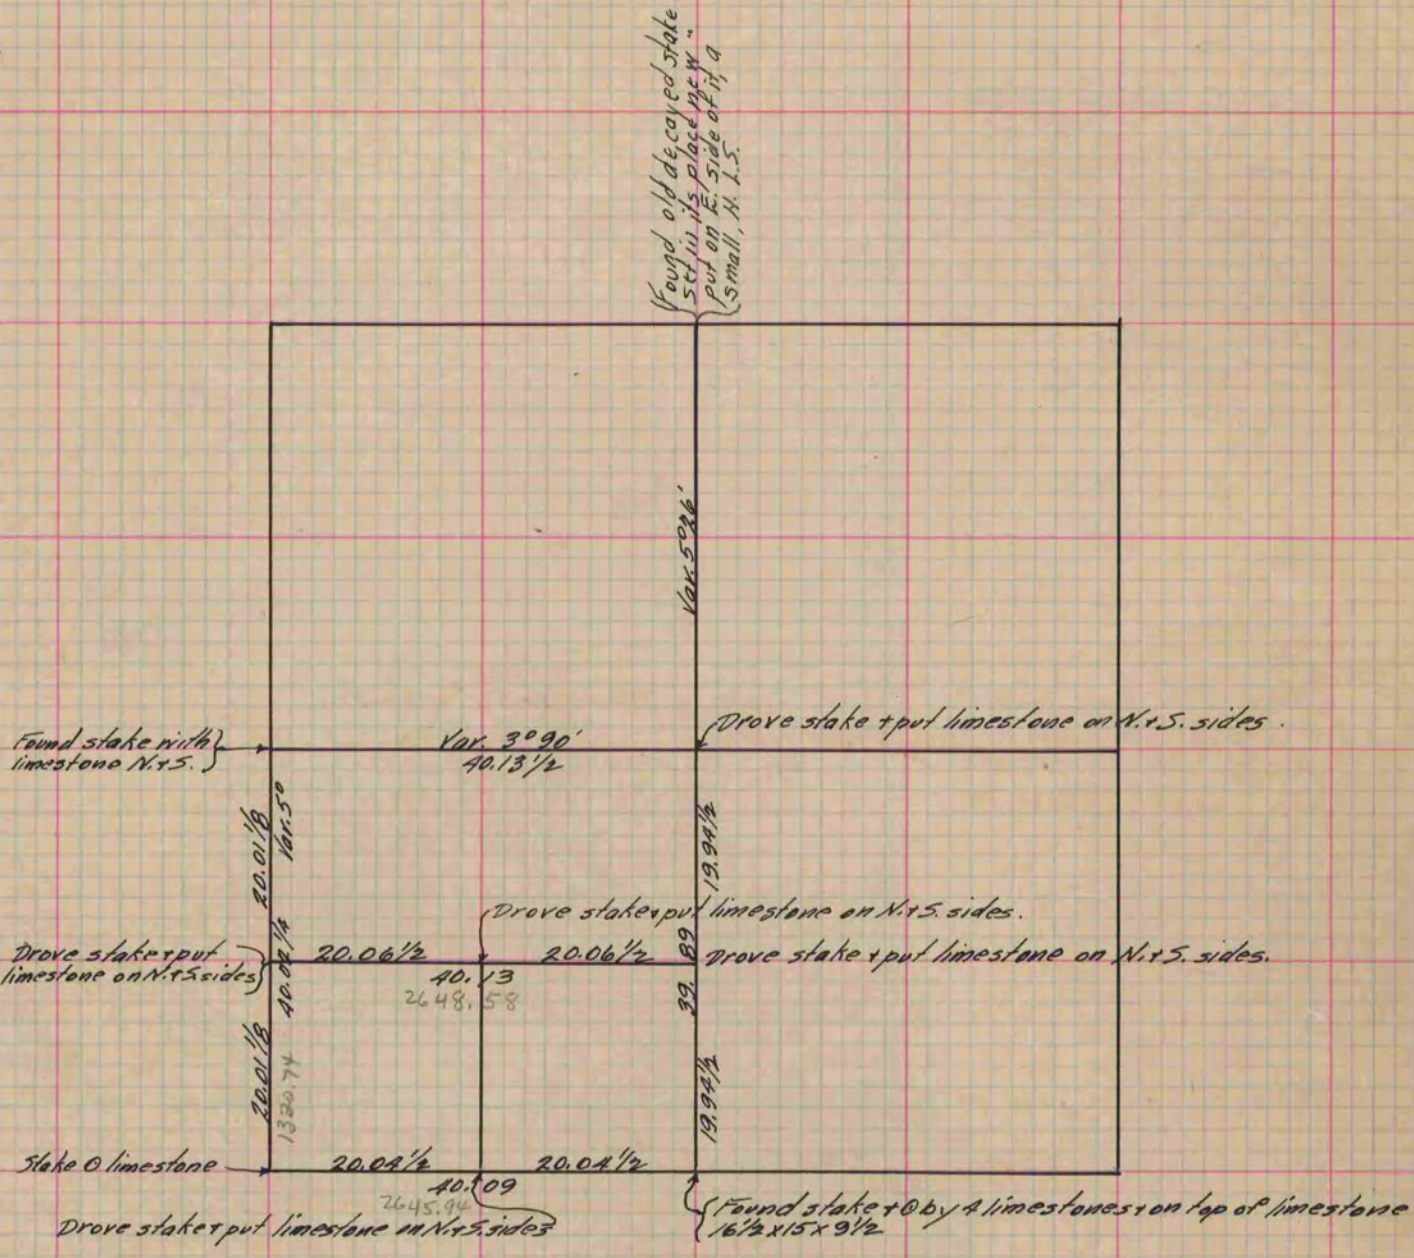

Copied from P. 231 Vol. 2 County Surveyor's Record.