

# PLAT AND RECORD


Of a Survey on Section 2 T 2 R 13 E. of the 4 P. M. in Harmony Township  
Rock County, Wisconsin, made May the 27<sup>th</sup> 1873

I hereby certify that the following is a correct record of said survey as made by me.

COUNTY BUILDING  
IN CITY OF BELOIT

(Signed) R. K. Lee  
RKL

Deputy  
County Surveyor.

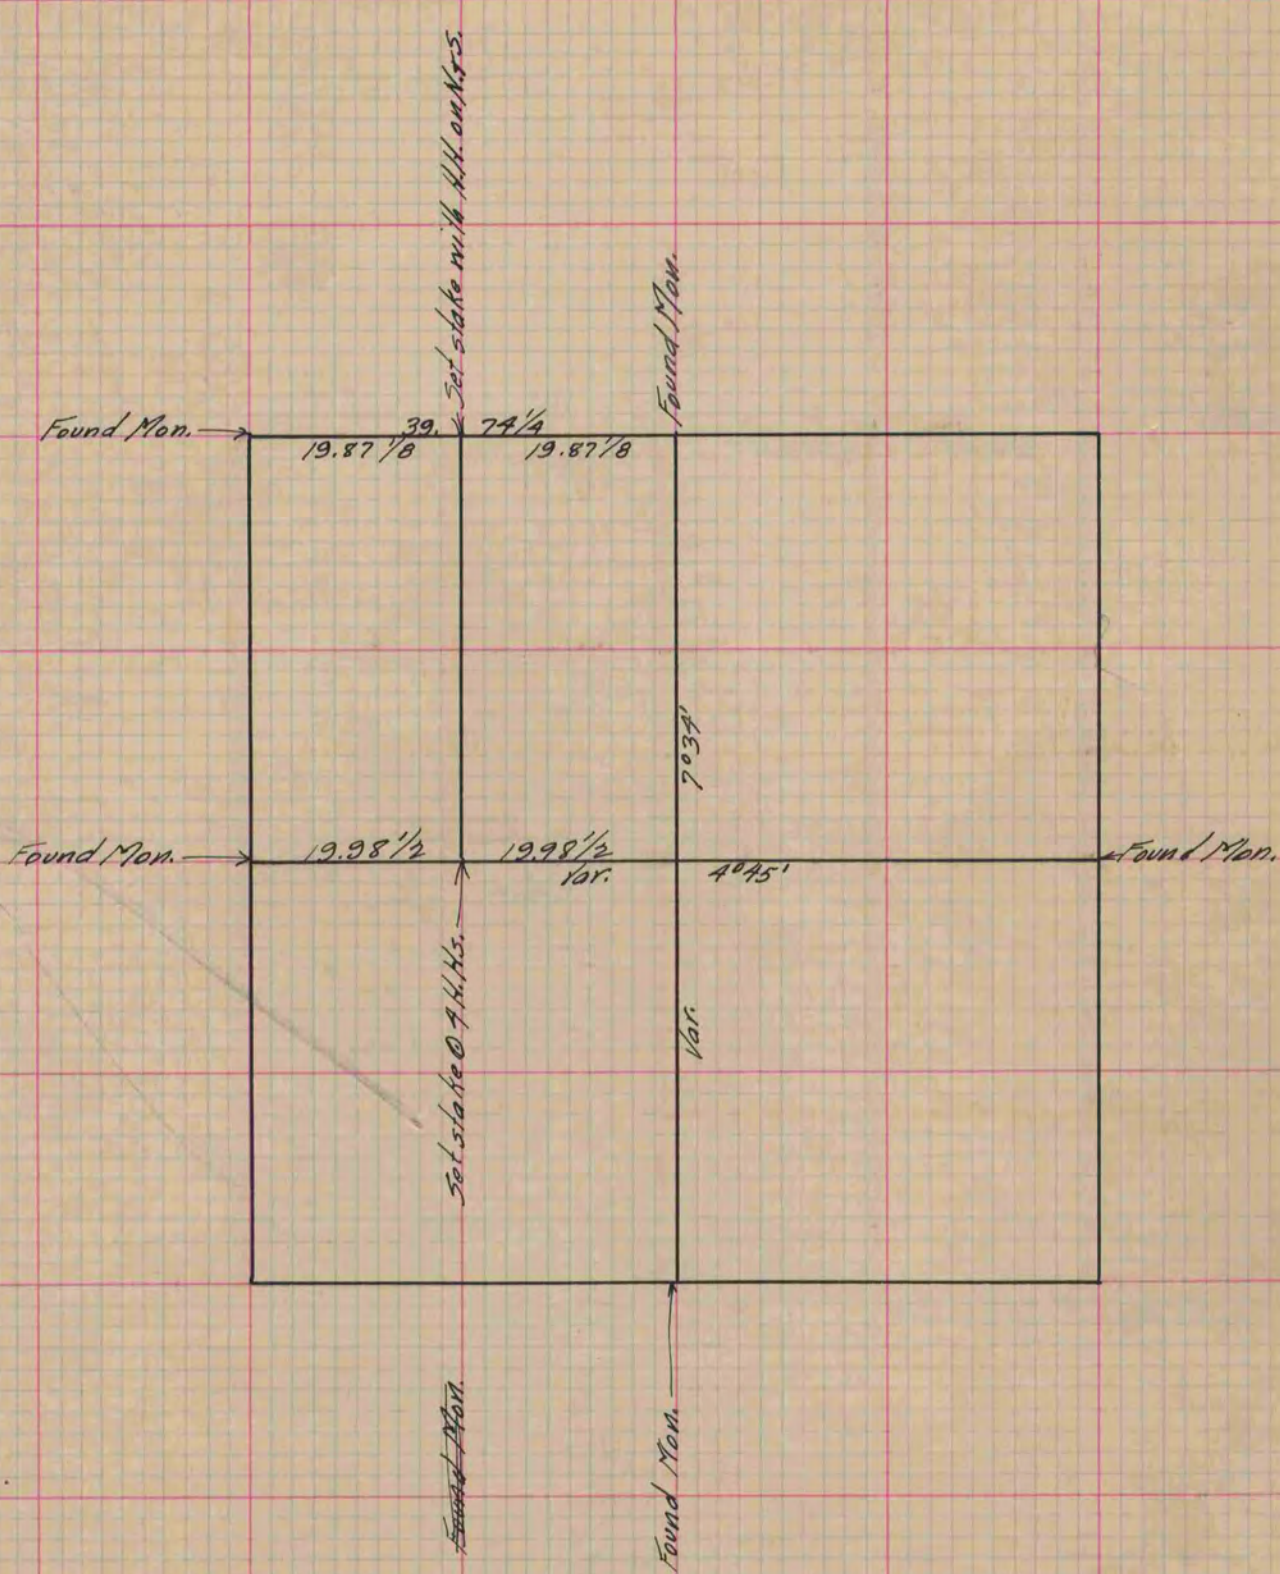

Copied from Page 60 Vol. 2 Original County Surveyors Record