

PLAT AND RECORD


Of a Survey on Section 6 T 3 R 11 E. of the 4 P. M. in Center Township
Rock County, Wisconsin, made September the 29 1876

I hereby certify that the following is a correct record of said survey as made by me.

COUNTY BUILDING
IN CITY OF BELOIT

(Signed) Edward Ruger
1876

County Surveyor.

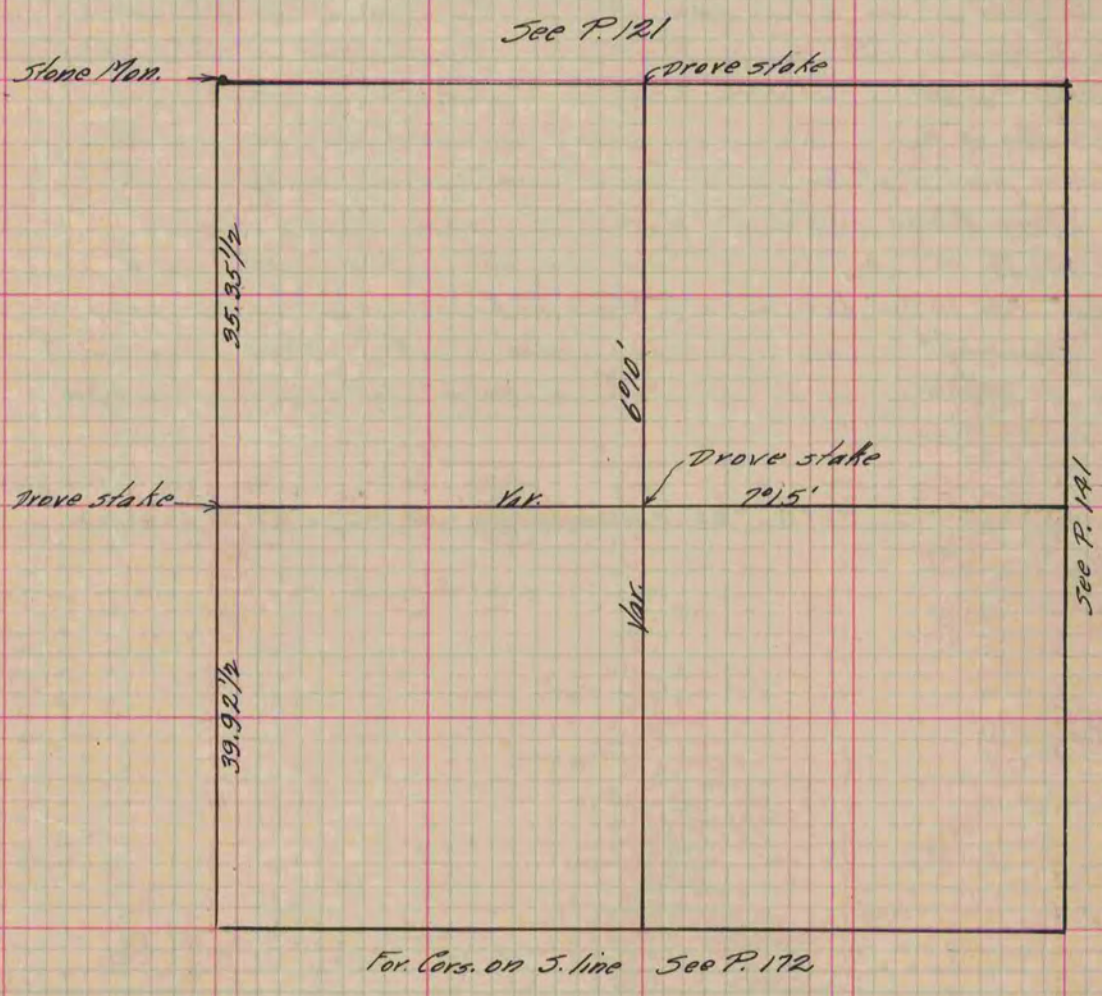

Copied from P. 173 Vol. 2 Original County Surveyor's Record.