


PLAT AND RECORD

Of a Survey on Section 11 T 1 R 10 E. of the 4 P. M. in Aron Township
Rock County, Wisconsin, made October the 3 1867

I hereby certify that the following is a correct record of said survey as made by me.

COUNTY BUILDING
IN CITY OF БЕЛОIT

(Signed) S. D. Locke
S. D. Locke County Surveyor.

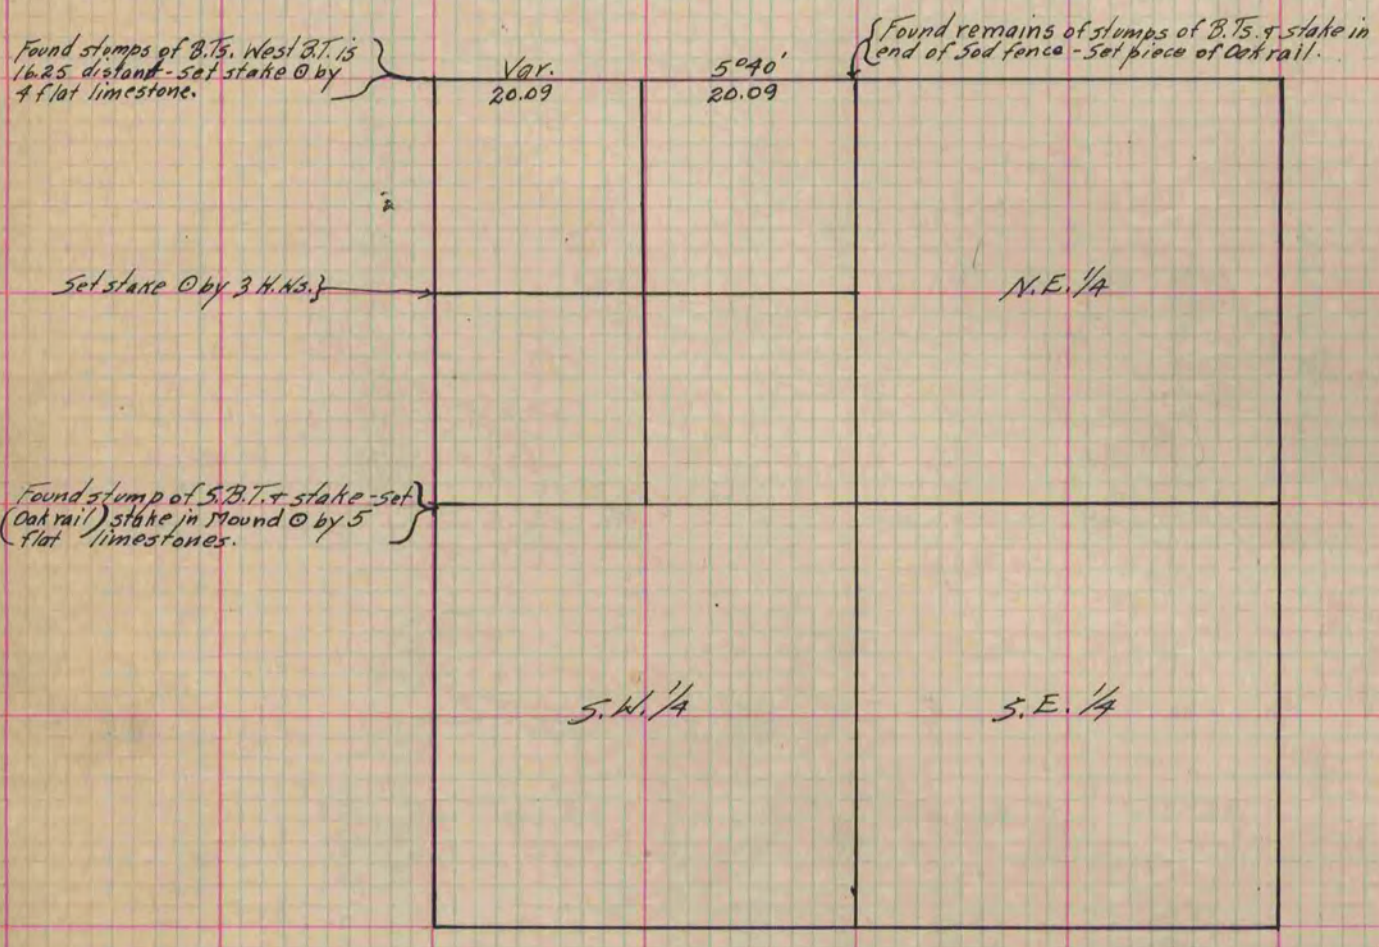

Copied from Page 250 Vol. 1. Original County Surveyor's Record.