

PLAT AND RECORD

Of a Survey on Section 3 T 2 R 19 E. of the 4 P. M. in Bradford Township


Rock County, Wisconsin, made May the 17+18 1871

I hereby certify that the following is a correct record of said survey as made by me.

COUNTY BUILDING
IN CITY OF БЕЛОIT

(Signed) Edward Ruger

County Surveyor.

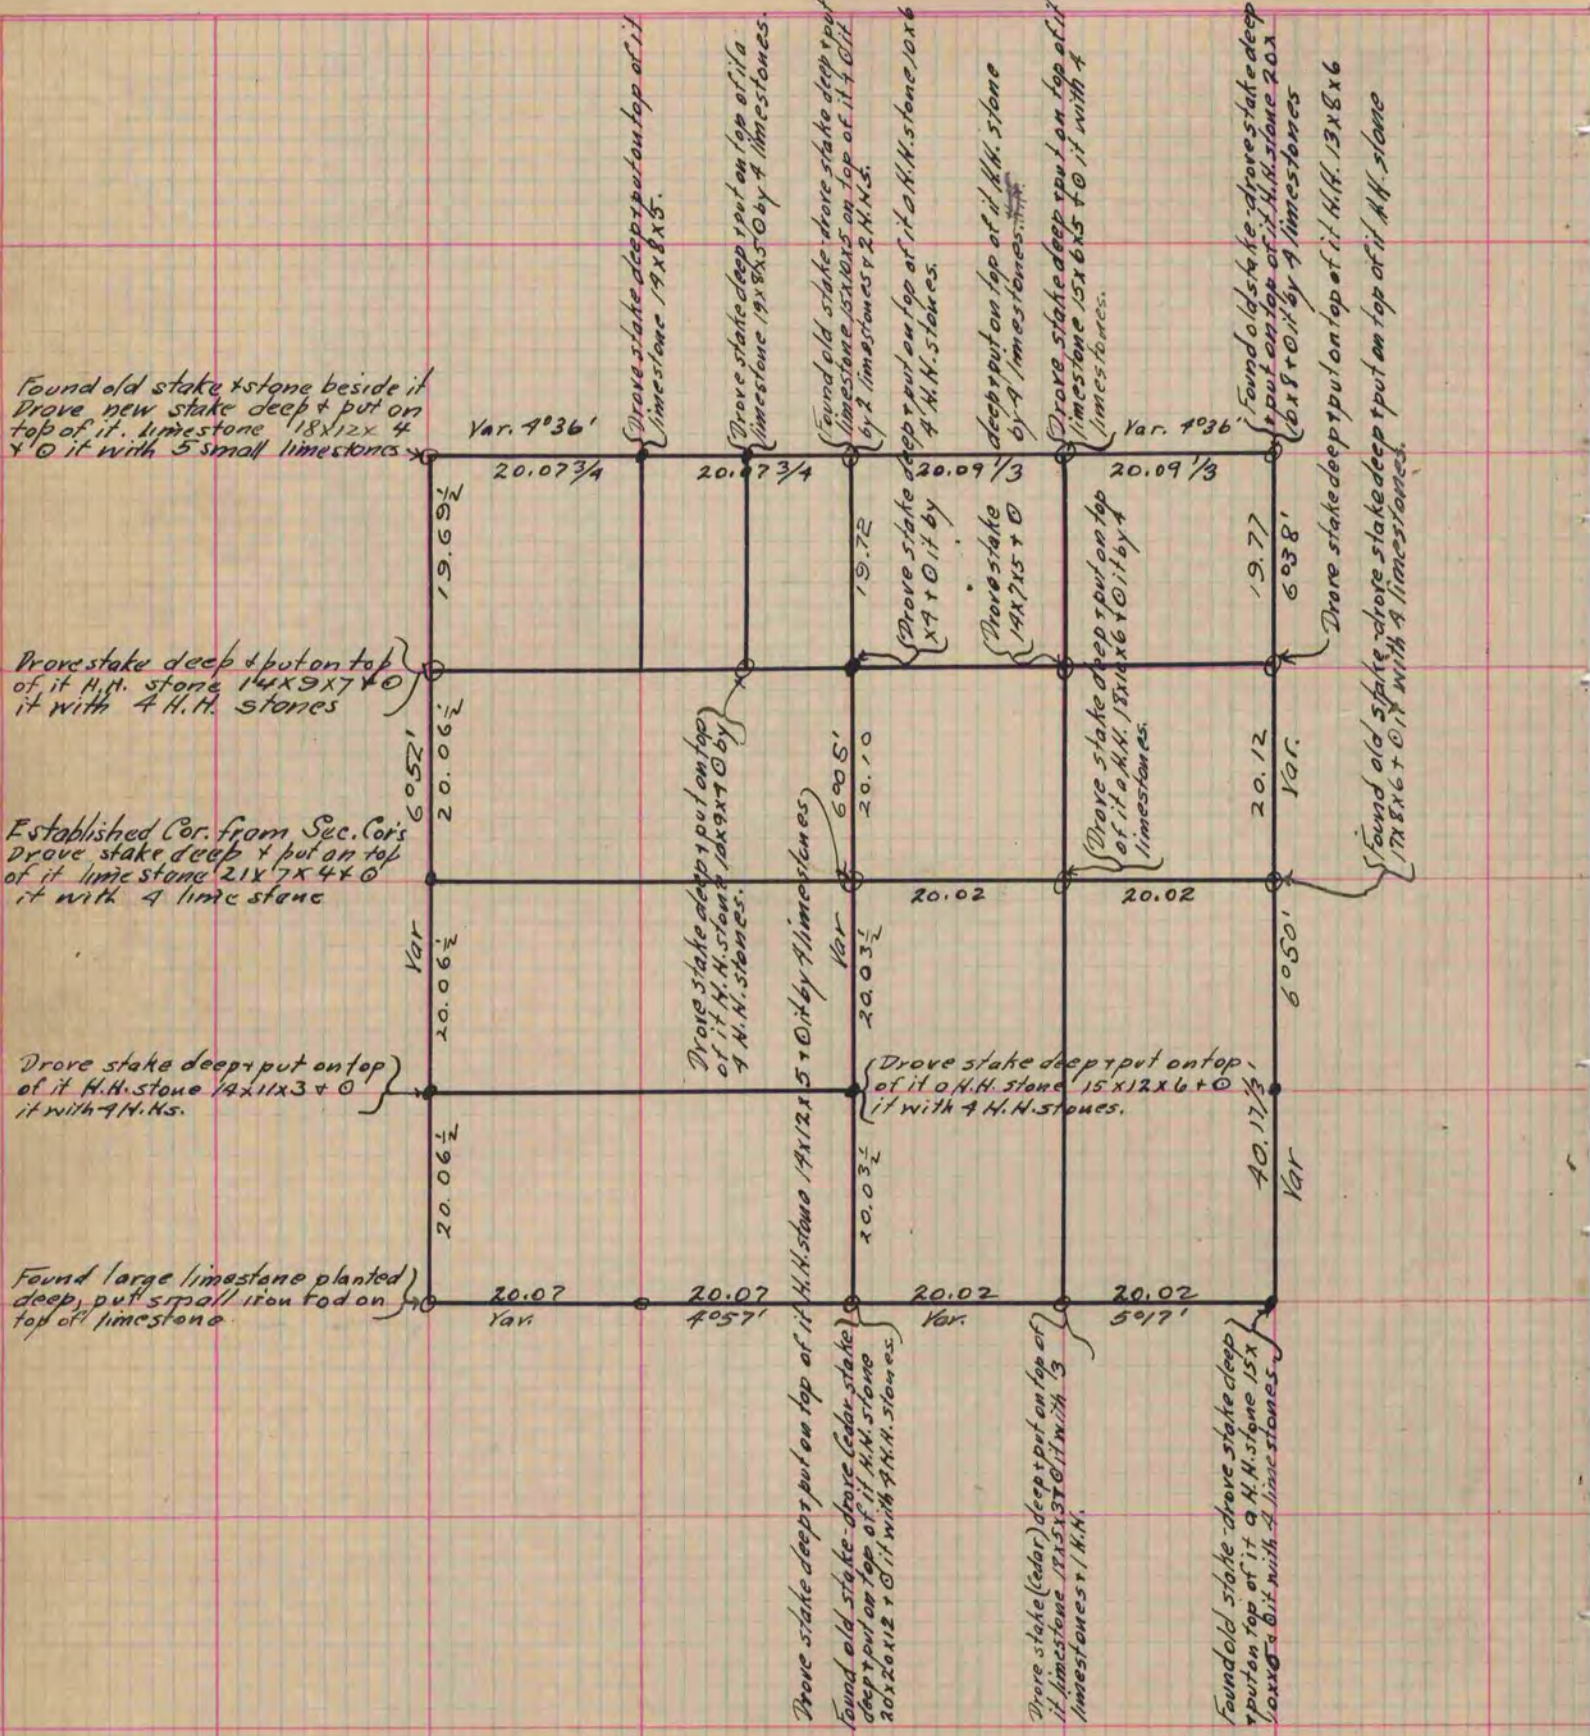

Copied from P. 39 Vol. 2 Original County Surveyor's Record.