

# PLAT AND RECORD

Of a Survey on Section 8 T 2 R 10 E. of the 4 P. M. in Spring Valley Township


Rock County, Wisconsin, made June the 6<sup>th</sup> & 7<sup>th</sup> 1855

I hereby certify that the following is a correct record of said survey as made by me.

COUNTY BUILDING  
IN CITY OF БЕЛОIT

(Signed) Joseph Church  
JAC

County Surveyor.

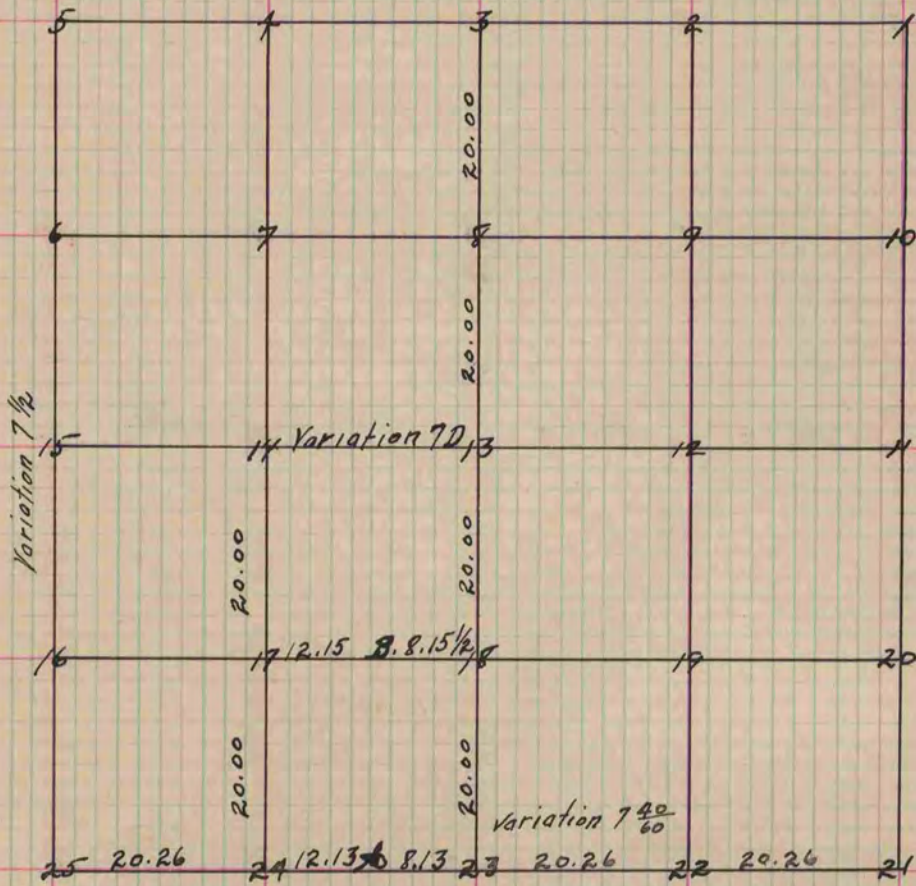

- |         |         |                          |            |         |                          |            |
|---------|---------|--------------------------|------------|---------|--------------------------|------------|
| Fig. 13 | Bur. O. | 24 S. $59\frac{1}{2}$ E. | 200 links. | Bur. O. | 16 S. $28\frac{1}{2}$ E. | 115 links. |
| Fig. B. | " "     | 24 N. 48                 | W. 688 "   | " "     | N. 25                    | W. 335 "   |
| Fig. 16 | " "     | 18 S. 12                 | E. 196 "   | " "     | S. $79\frac{1}{2}$       | E. 112 "   |
| Fig. 23 | " "     | 5.59                     | W. 48 "    | " "     | 20 S. $17\frac{1}{2}$    | W. 87 "    |
| Fig. 18 | " "     | 20 N. $14\frac{1}{2}$    | W. 25 "    | " "     | 20 S. 81                 | W. 17 "    |
| Fig. 17 | " "     | 20 S. 51                 | E. 57 "    | " "     | 24 N. 26                 | W. 53 "    |
| Fig. 8  | " "     | 24 S. 63                 | E. 135 "   | " "     | 18 S. 19                 | W. 66 "    |

Copied from Page 43 Vol. 1 Original County Surveyors Record.