

# PLAT AND RECORD

Of a Survey on Section 22 T 3 R 14 E. of the 4 P. M. in Sohnstown Township

Rock County, Wisconsin, made May the 6 1884


I hereby certify that the following is a correct record of said survey as made by me.

COUNTY BUILDING  
IN CITY OF BELOIT

(Signed) Edward Ruger  
ERUGER

County Surveyor.

(See P. 13 samebook.)

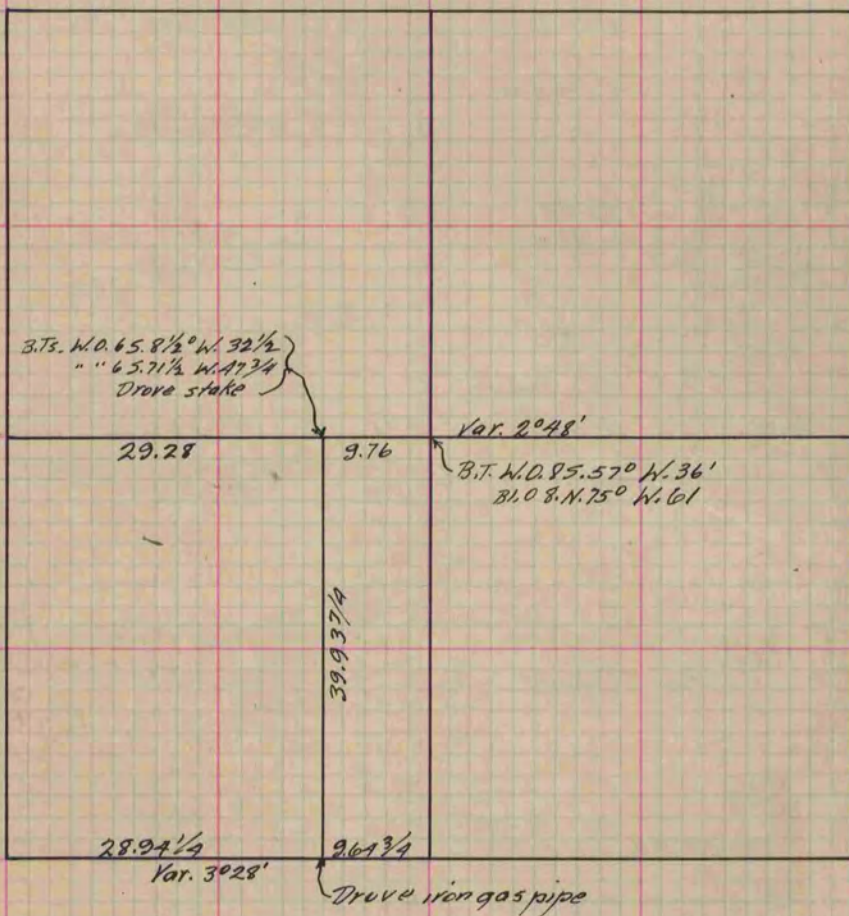

Copied from P. 312 Vol. 2 County Surveyor's Record.