

# PLAT AND RECORD

377

Of a Survey on Section 31 T 4 R 14 E. of the 4 P. M. in Lima Township


Rock County, Wisconsin, made Sept. the 8th 1884

I hereby certify that the following is a correct record of said survey as made by me.

COUNTY BUILDING  
IN CITY OF BELoit

(Signed) Edward Ruger

County Surveyor.

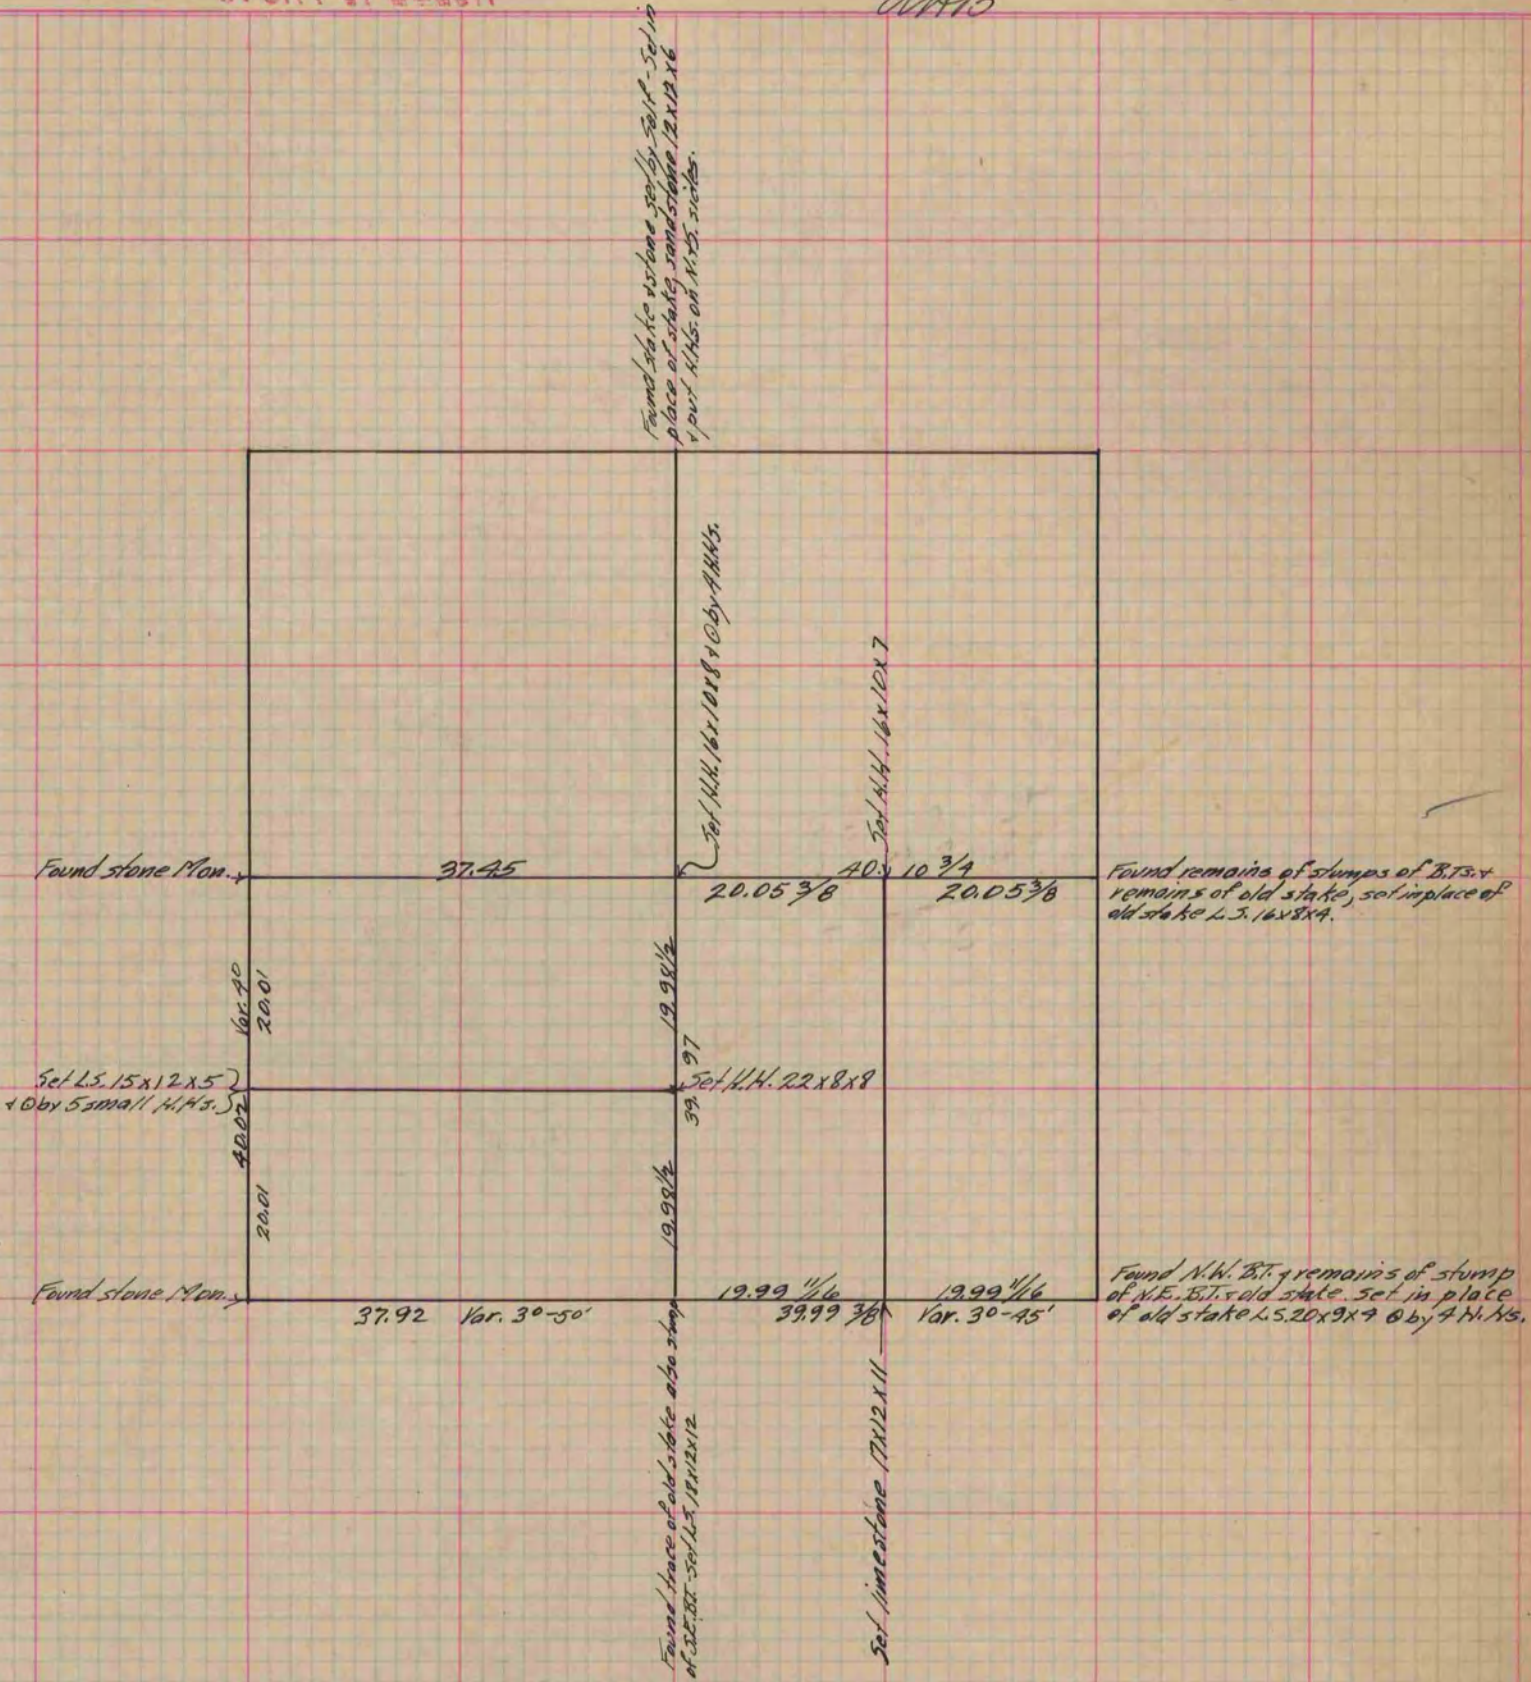

Copied from P. 30A Vol. 2 County Surveyor's Record.