

PLAT AND RECORD

COUNTY BUILDING
IN CITY OF БЕЛОИТ


Of a Survey on Section 35 T 4 R 12 E. of the 4 P. M. in Fulton Township

Rock County, Wisconsin, made May the 13, 1875

I hereby certify that the following is a correct record of said survey as made by me.

(Signed) Edward Ryger
R.A.B.

County Surveyor.

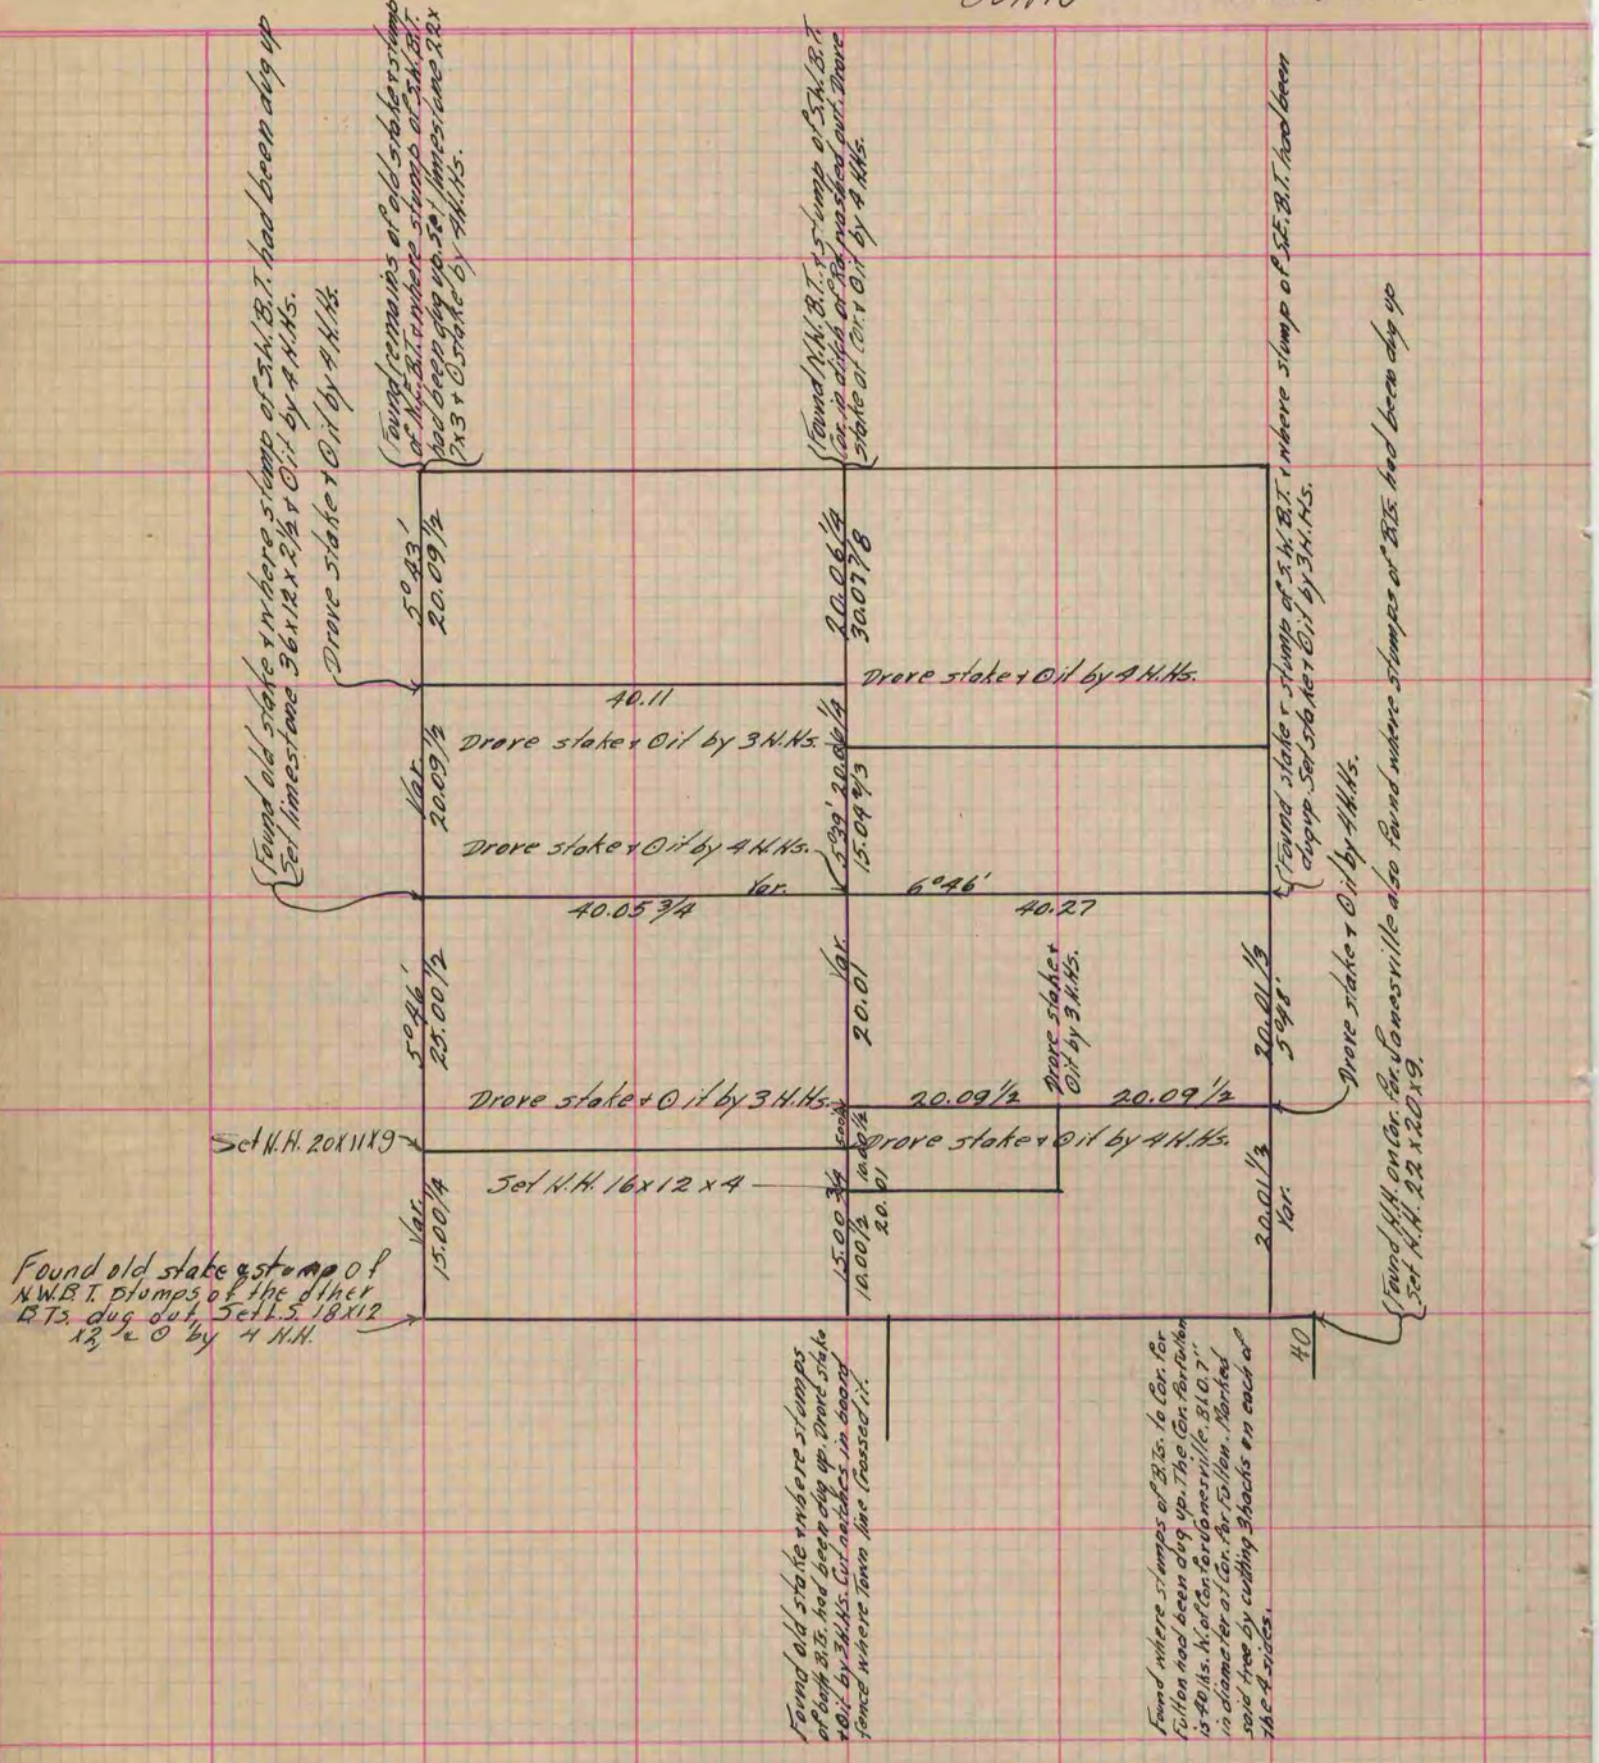

Copied From P. 143 Vol. 2 Original County Surveyor's Record.