

# PLAT AND RECORD

Of a Survey on Section **32** T **2** R **12** E. of the 4 P. M. in **ROCK** Township  
 Rock County, Wisconsin, made **APRIL** the **23rd** 19**66**

I hereby certify that the following is a correct record of said survey as made by me.

**COUNTY BUILDING  
 IN CITY OF БЕЛОIT**

*Richard A. Batteman*

County Surveyor.

THE GEO. D. SARGENT COMPANY, ST. LOUIS

○ = 1" pipe




G. Hanson  
 J. Hauser  
 C. Garner

Found pipe set by C. Shimeal  
 at the N.W.X. Sec. 32-2-12

See page 205

SEE PAGE 287, VOL. 4

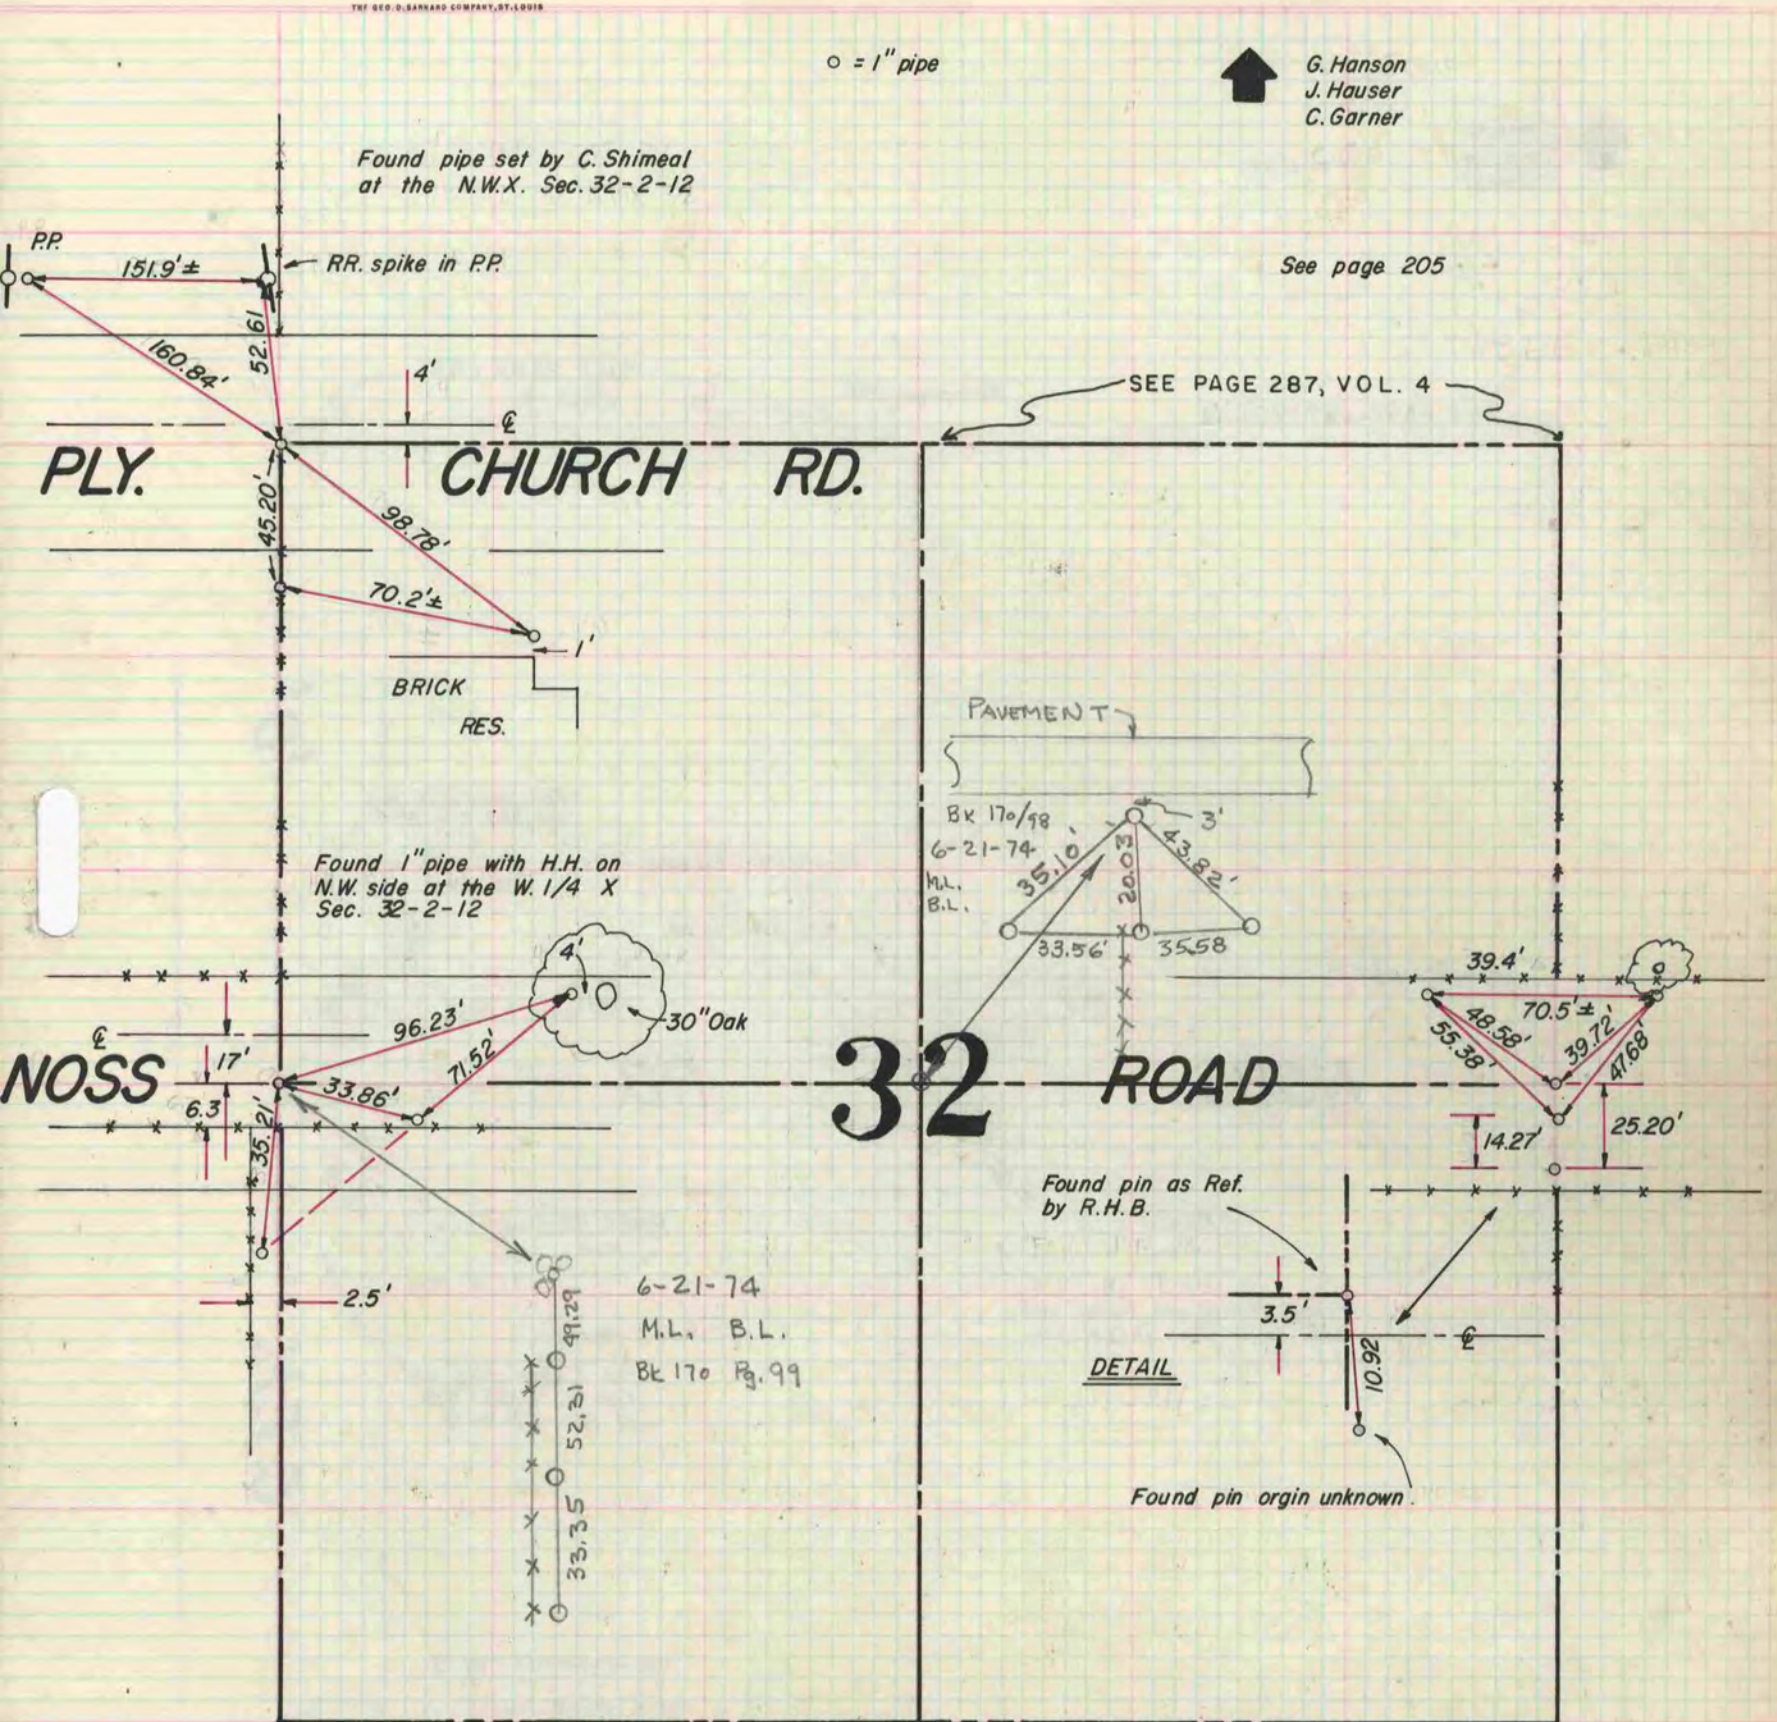

Found pin as Ref.  
 by R.H.B.

DETAIL

Found pin origin unknown.

6-21-74  
 M.L. B.L.  
 BK 170 Pg. 99