

# PLAT AND RECORD


161

Of a Survey on Section 17 T 2 R 13 E. of the 4 P. M. in LaPrairie Township  
Rock County, Wisconsin, made May the 2nd 1861

I hereby certify that the following is a correct record of said survey as made by me.

COUNTY BUILDING  
IN CITY OF БЕЛОIT

(Signed) *Edward Ruger*  
*ERUG* County Surveyor.

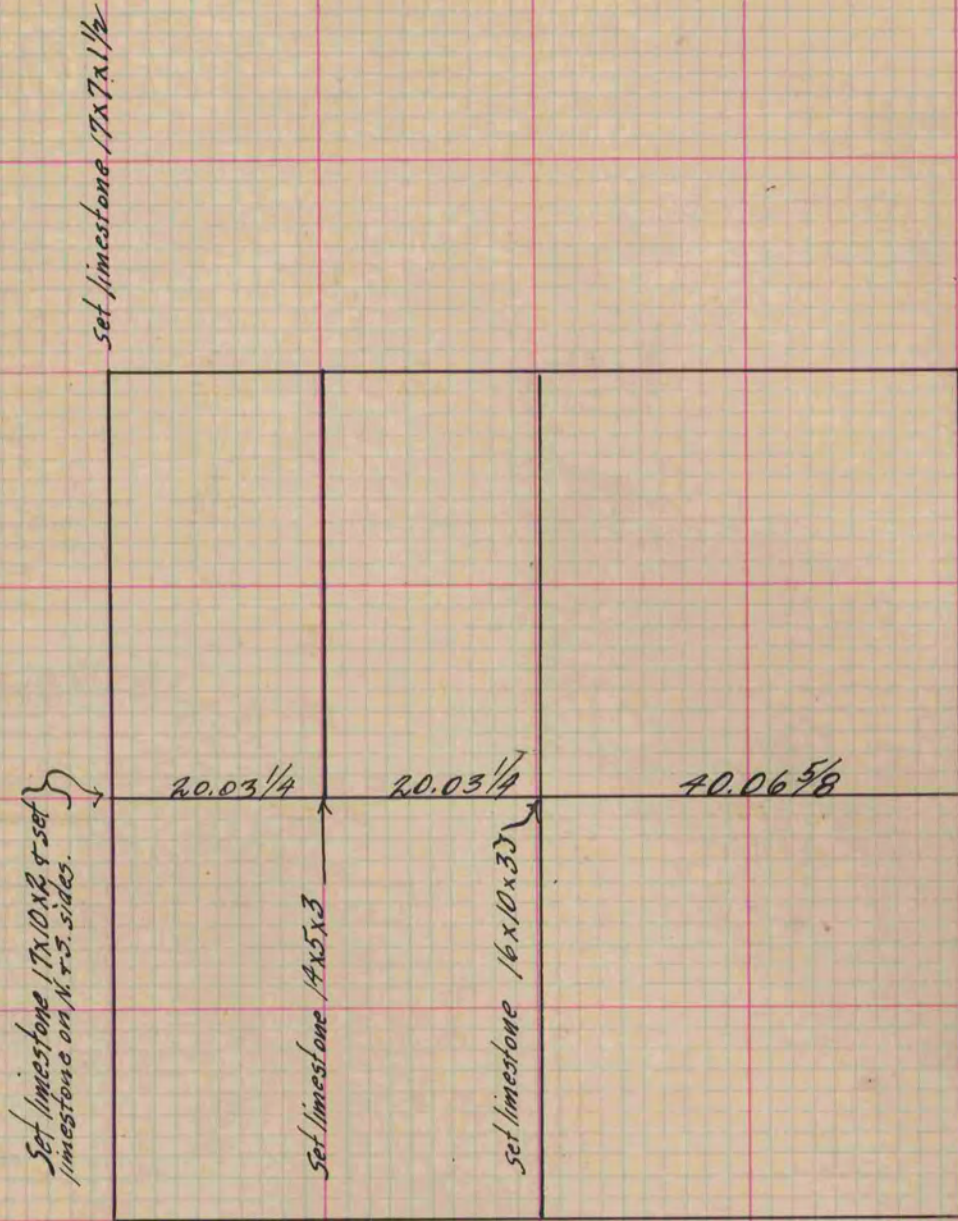

*Copied from Page 170 Vol. One Original County Surveyor's Record.*