

PLAT AND RECORD

Of a Survey on Section **3** **3N** **13E** **HARMONY**
34 T **4N** R **13** E. of the 4 P. M. in **MILTON** Township

Rock County, Wisconsin, made **MAY** the **1** 19**68**



I hereby certify that the following is a correct record of said survey as made by me.

COUNTY BUILDING
IN CITY OF BELOIT

Rob Bottoman Jr

County Surveyor.

THE GEO. B. BARNARD COMPANY, ST.

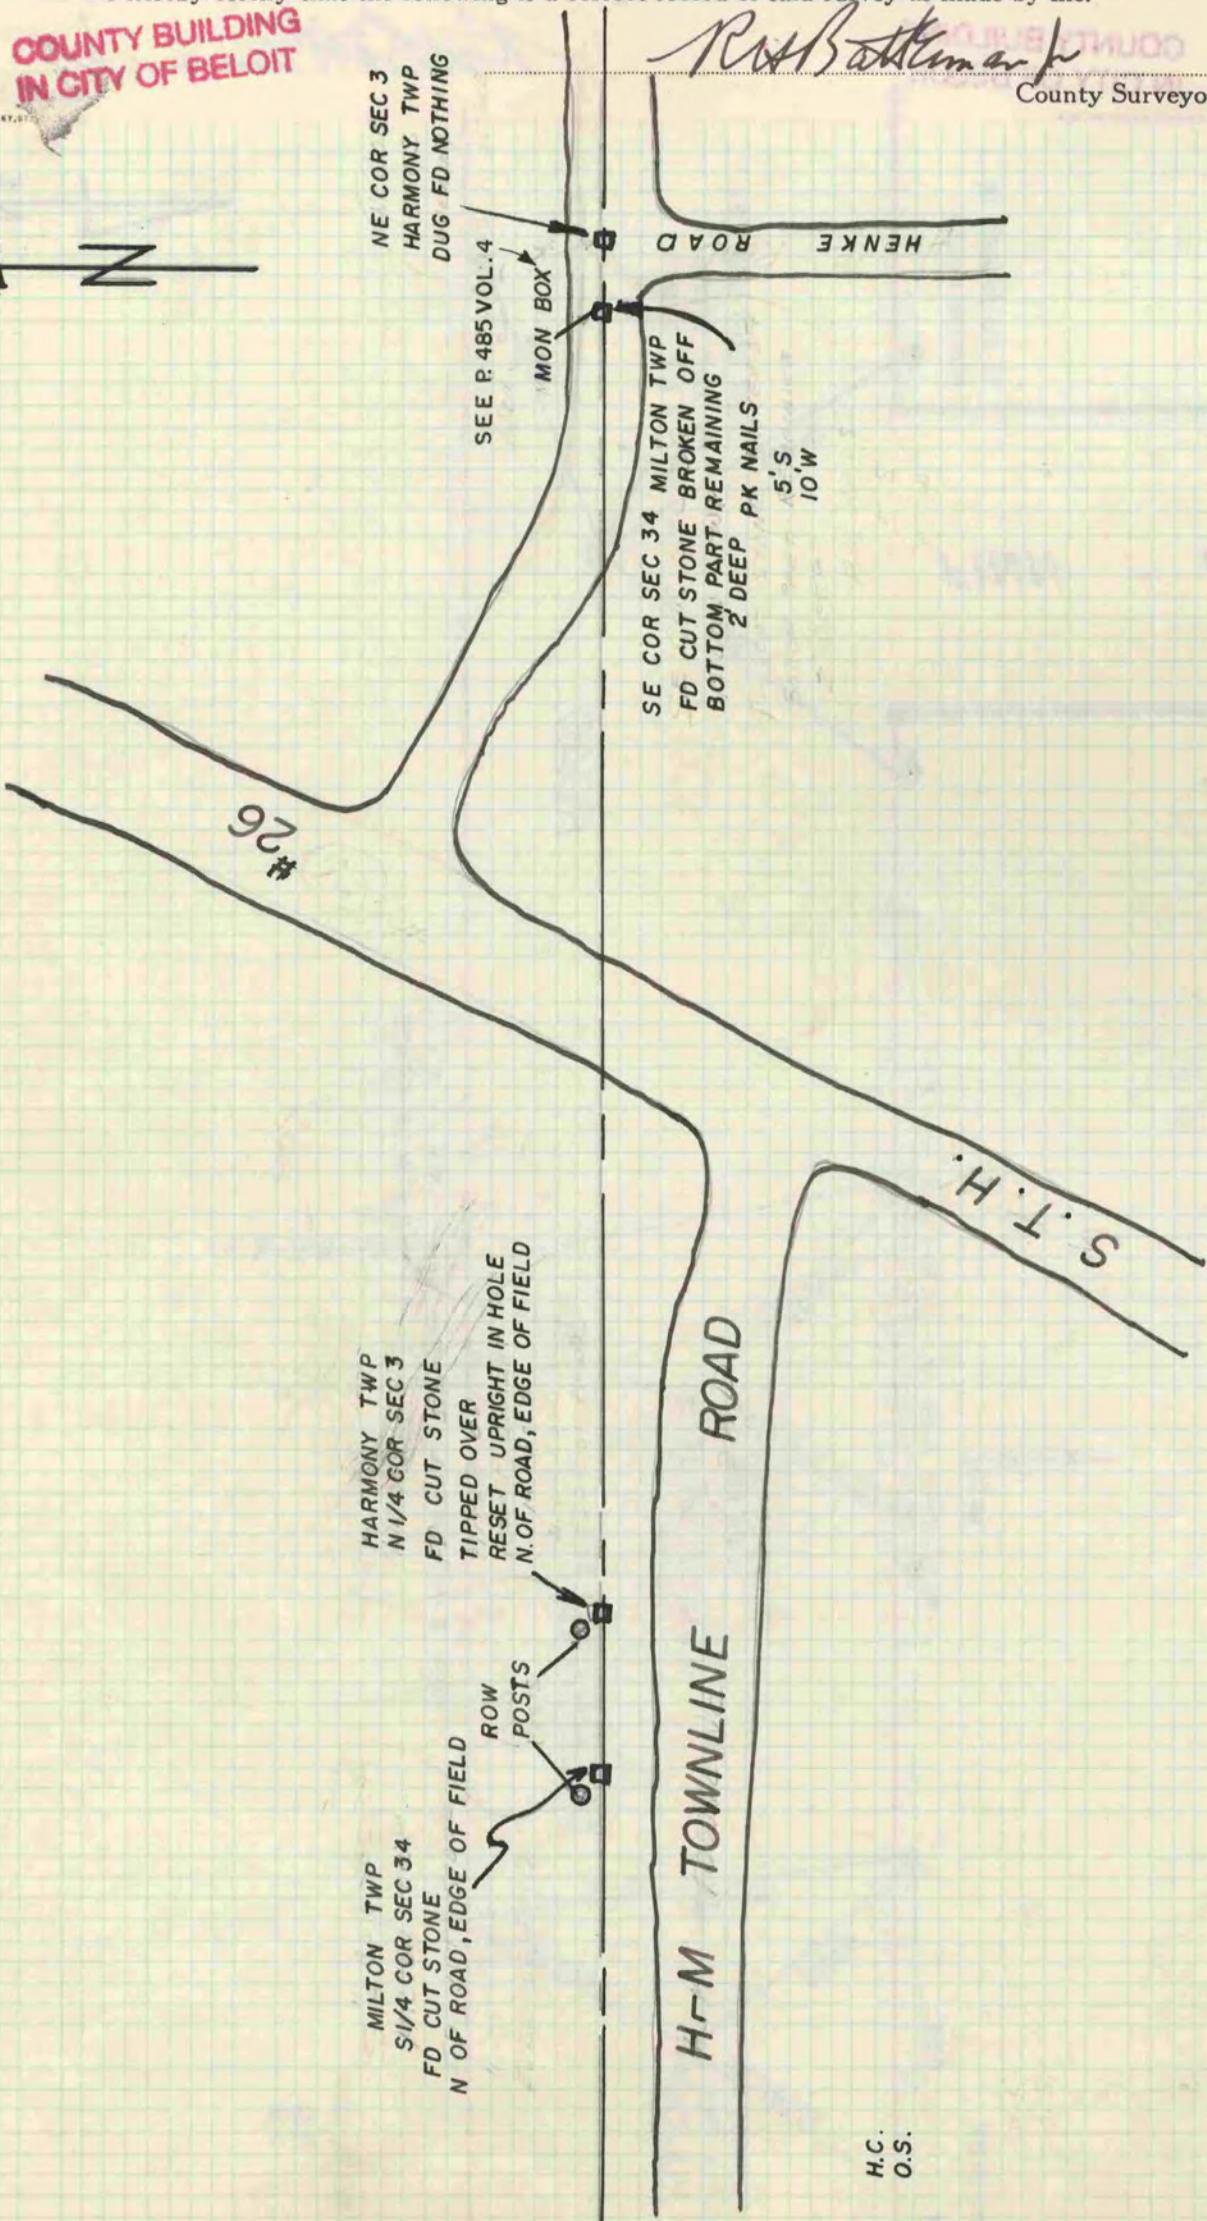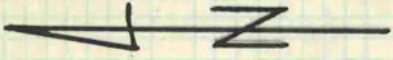

H.C.
O.S.