

# PLAT AND RECORD

Of a Survey on Section 6 T. 1 N. R. 10 E. of the 4 P. M. in AVON Township

Rock County, Wisconsin, made AUG the 18 1969


I hereby certify that the following is a correct record of said survey as made by me.

COUNTY BUILDING  
IN CITY OF BELOIT

*R. H. Atkinson*  
County Surveyor.

AUGUST 18, 1969

O = ALL REF 1" PIPE  
BY B.W. & M.L.

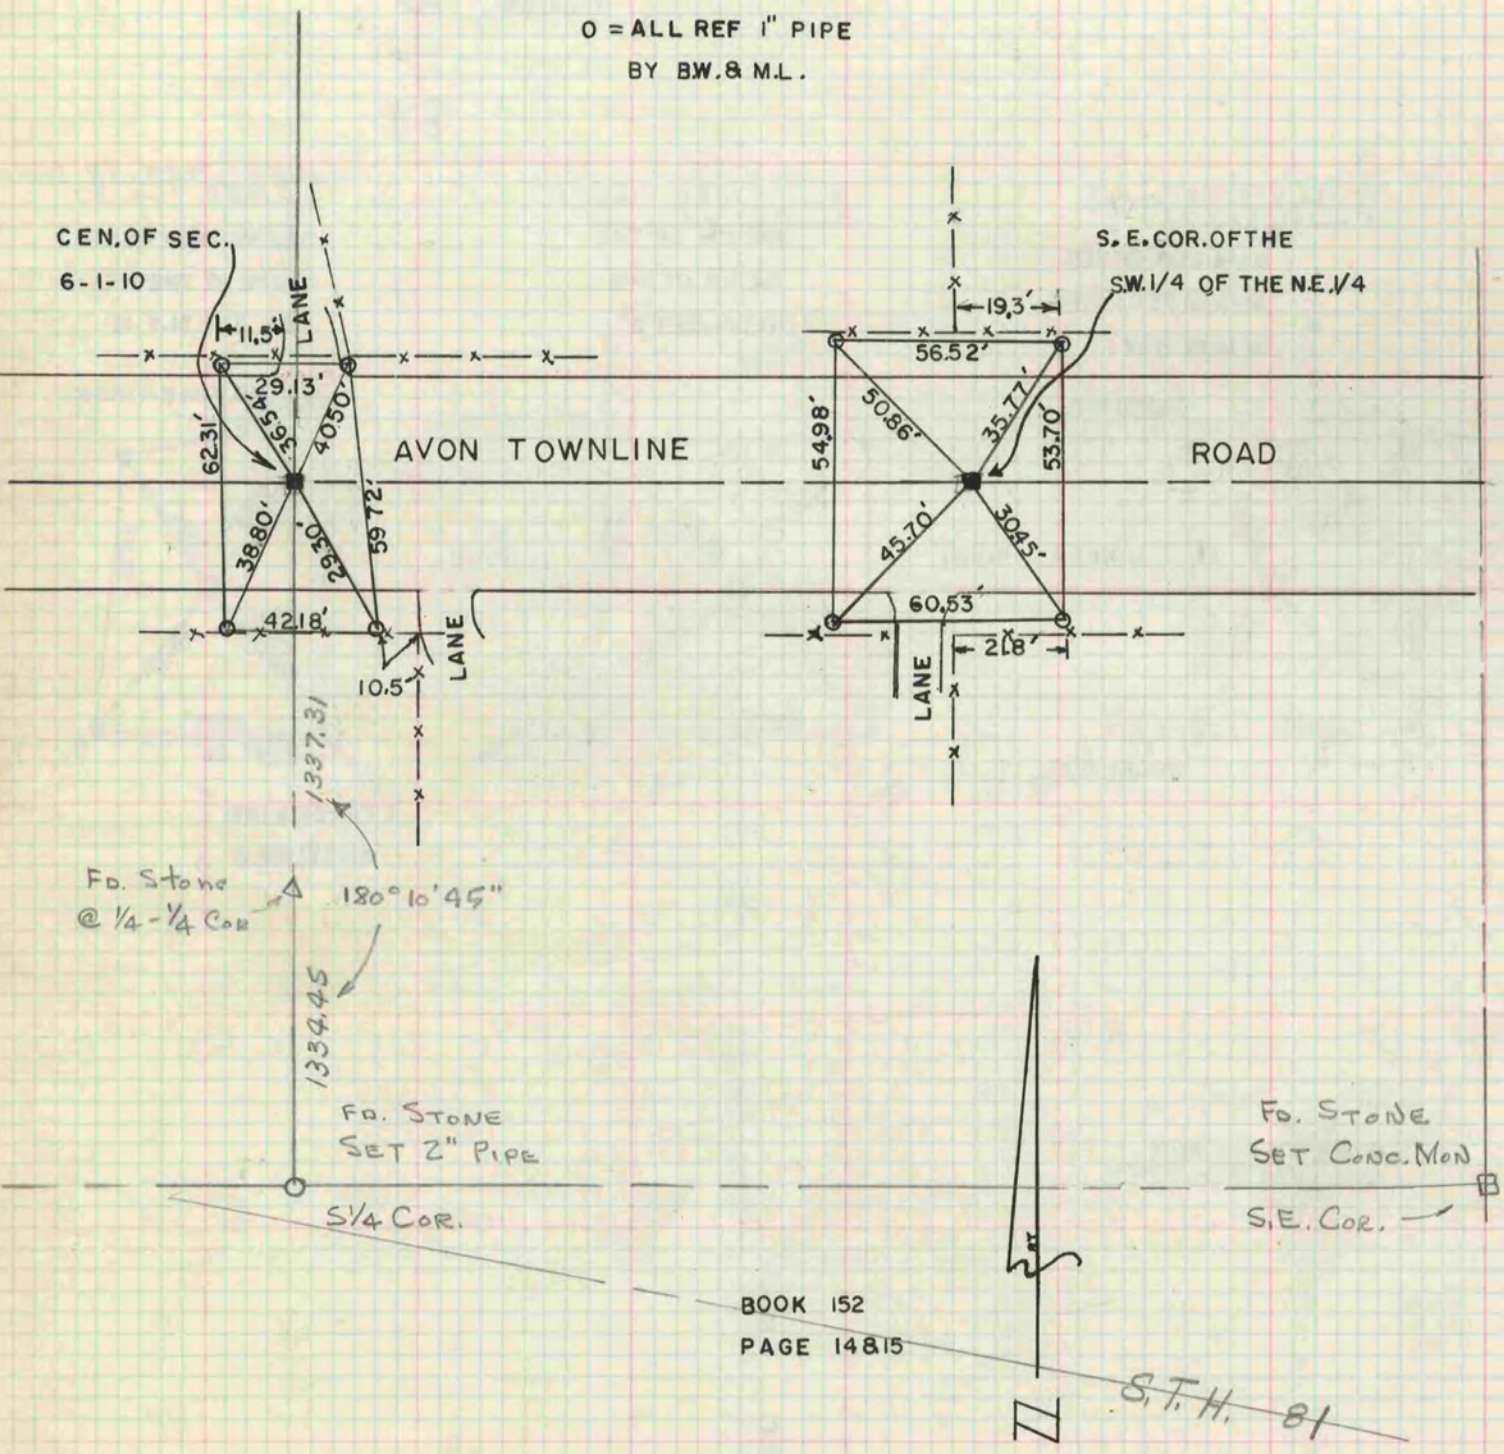

BOOK 152  
PAGE 14815

S.T.H. 81