

# PLAT AND RECORD

139

PG 157 JANESVILLE  
REC 12/12/75 DAB

Of a Survey on Section 16 T 1 R 12 E. of the 4 P. M. in Beloit Township




Rock County, Wisconsin, made July the 27<sup>th</sup> 1929

I hereby certify that the following is a correct record of said survey as made by me.

RAB

County Surveyor.

COUNTY BUILDING  
IN CITY OF БЕЛОИТ

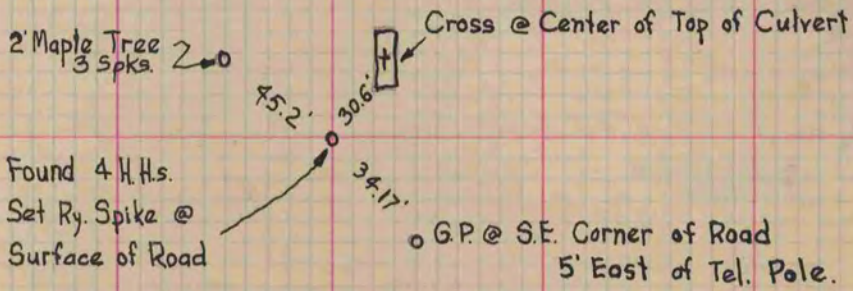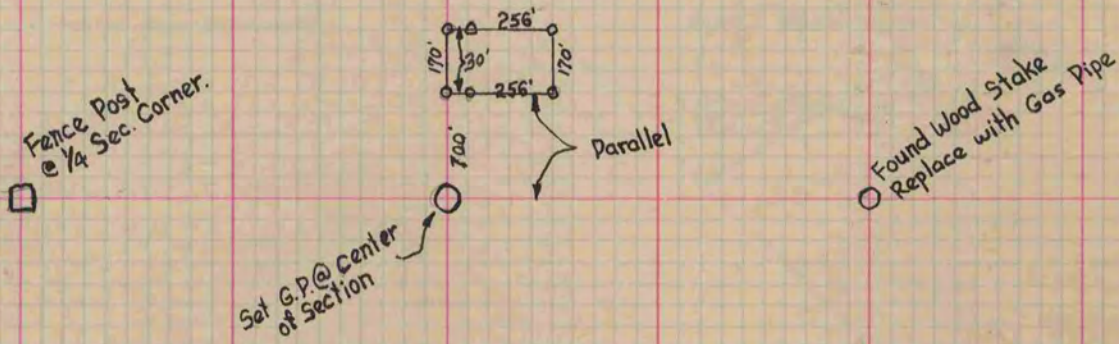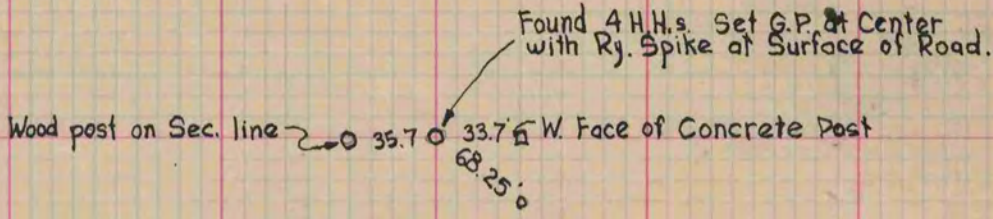

Order # 1668  
Book 45 Page 12