

PLAT AND RECORD

ROCK COUNTY RECORD
IN CITY OF BELOIT

Of a Survey on Section 27 T A R 10 E. of the 4 P. M. in Union Township

Rock County, Wisconsin, made September the 20 1866


I hereby certify that the following is a correct record of said survey as made by me.

COUNTY BUILDING
IN CITY OF BELOIT

(Signed) S.D. Locke
RMB

County Surveyor.

Found stumps of B.T.S. & remains of old stake
Set stake with large H.H. on E. & W. & smaller on N. & S.

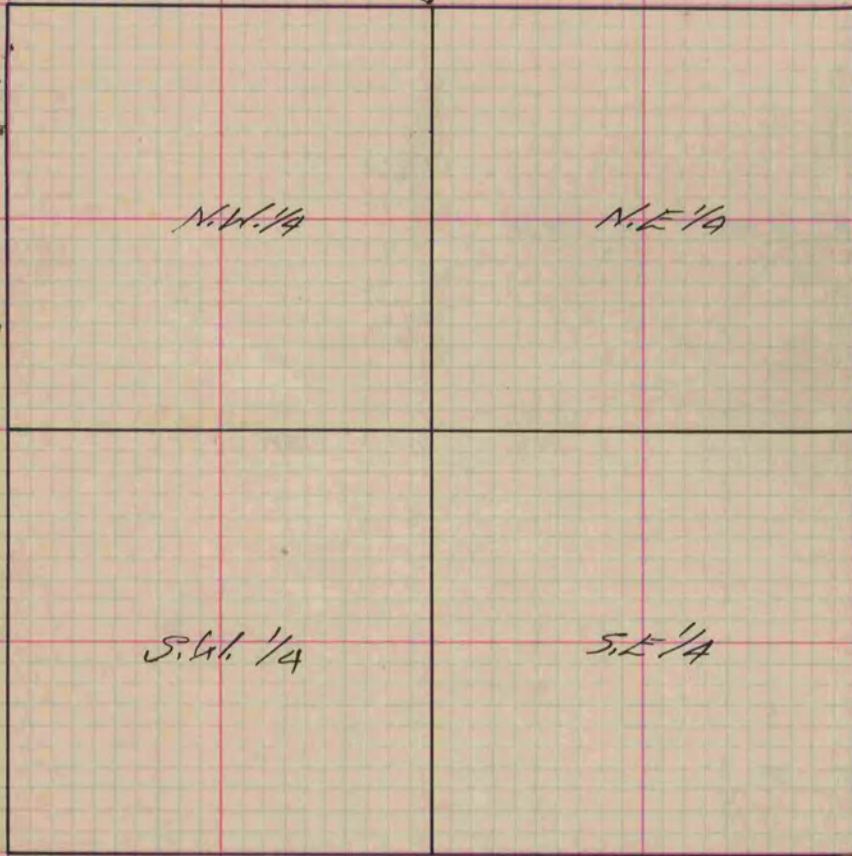

Copied from P. 271 Vol. 1 County Surveyors Record.