

# PLAT AND RECORD

137

PG 154  
JANESVILLE  
S.E.T.


Of a Survey on Section 36 T 1 R 12 E. of the 4 P. M. in Beloit Township  
Rock County, Wisconsin, made March the 23<sup>rd</sup> 1929

I hereby certify that the following is a correct record of said survey as made by me.

RHB

County Surveyor.

COUNTY BUILDING  
IN CITY OF БЕЛОИТ

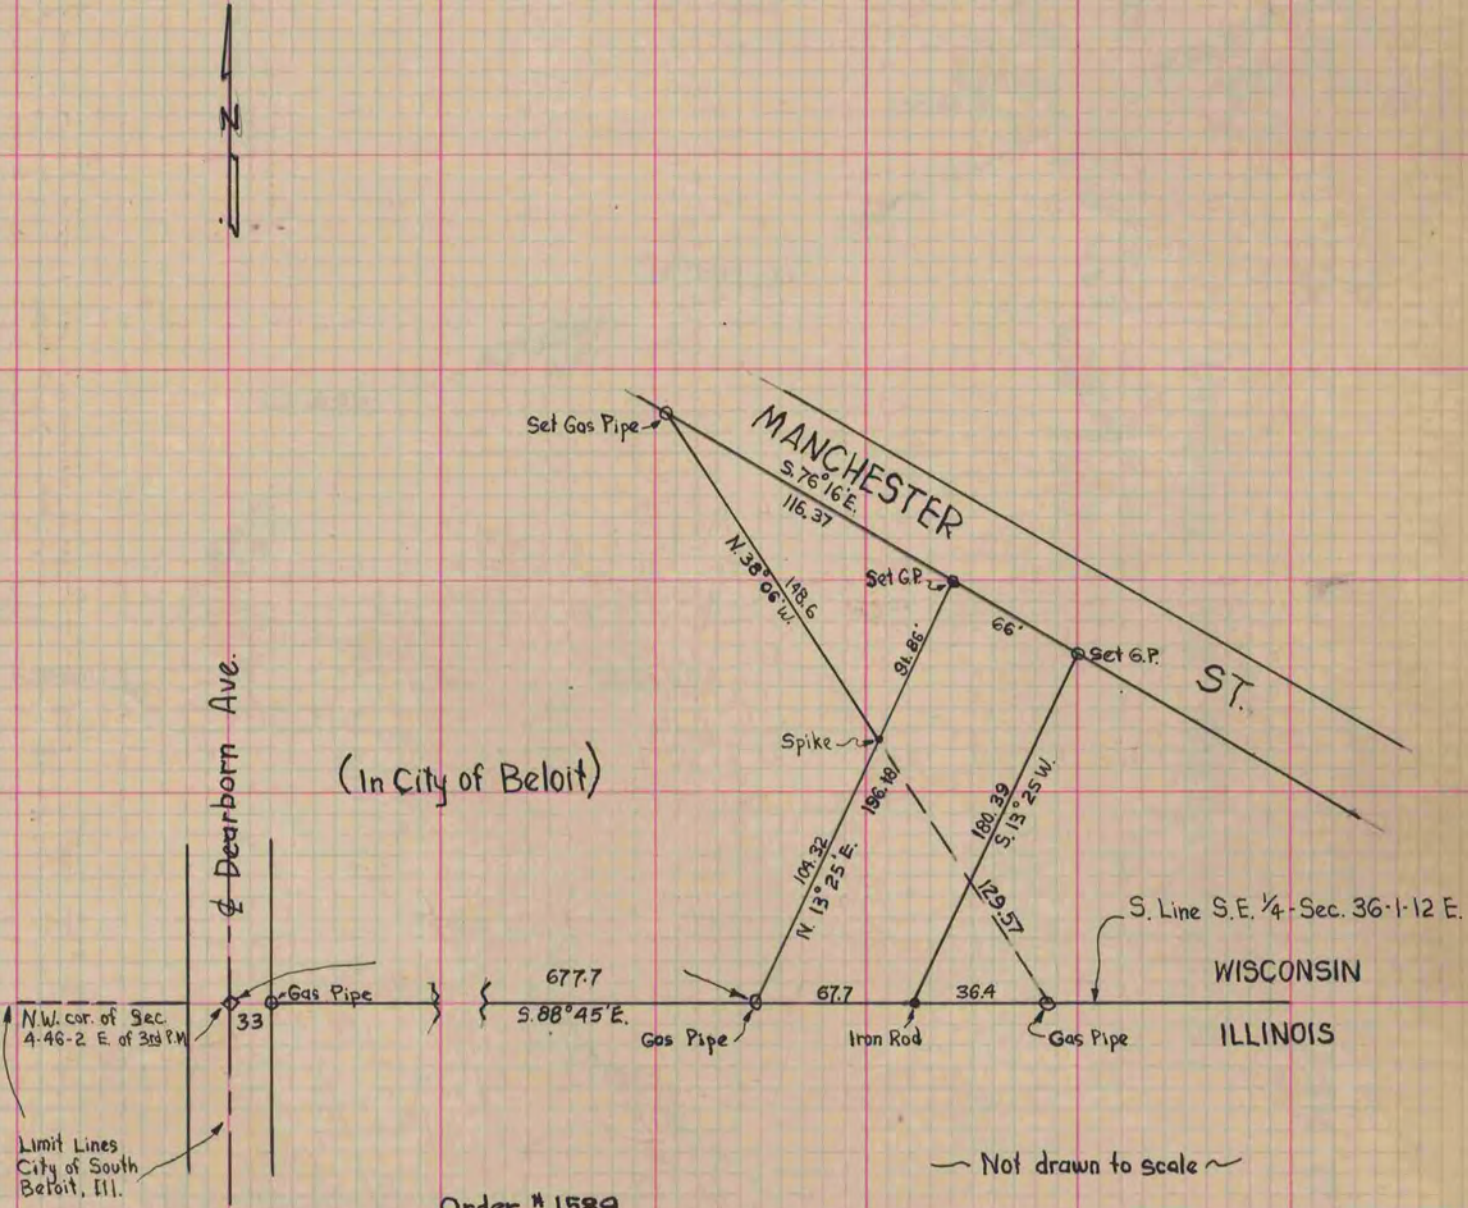

Order # 1589  
For Wilbur Cook  
Book 29 P. 80.