

PLAT AND RECORD

Of a Survey on Section 23 T 4 R 12 E. of the 4 P. M. in Fulton Township

Rock County, Wisconsin, made January the 19th 1885

I hereby certify that the following is a correct record of said survey as made by me.


COUNTY BUILDING  
IN CITY OF BELOIT

(Signed) Edward Roger.  
RHR

County Surveyor.

Found old stakes clump of 4 willows grown up  
around old willow stump.

Found large post & found S. H. B.T.

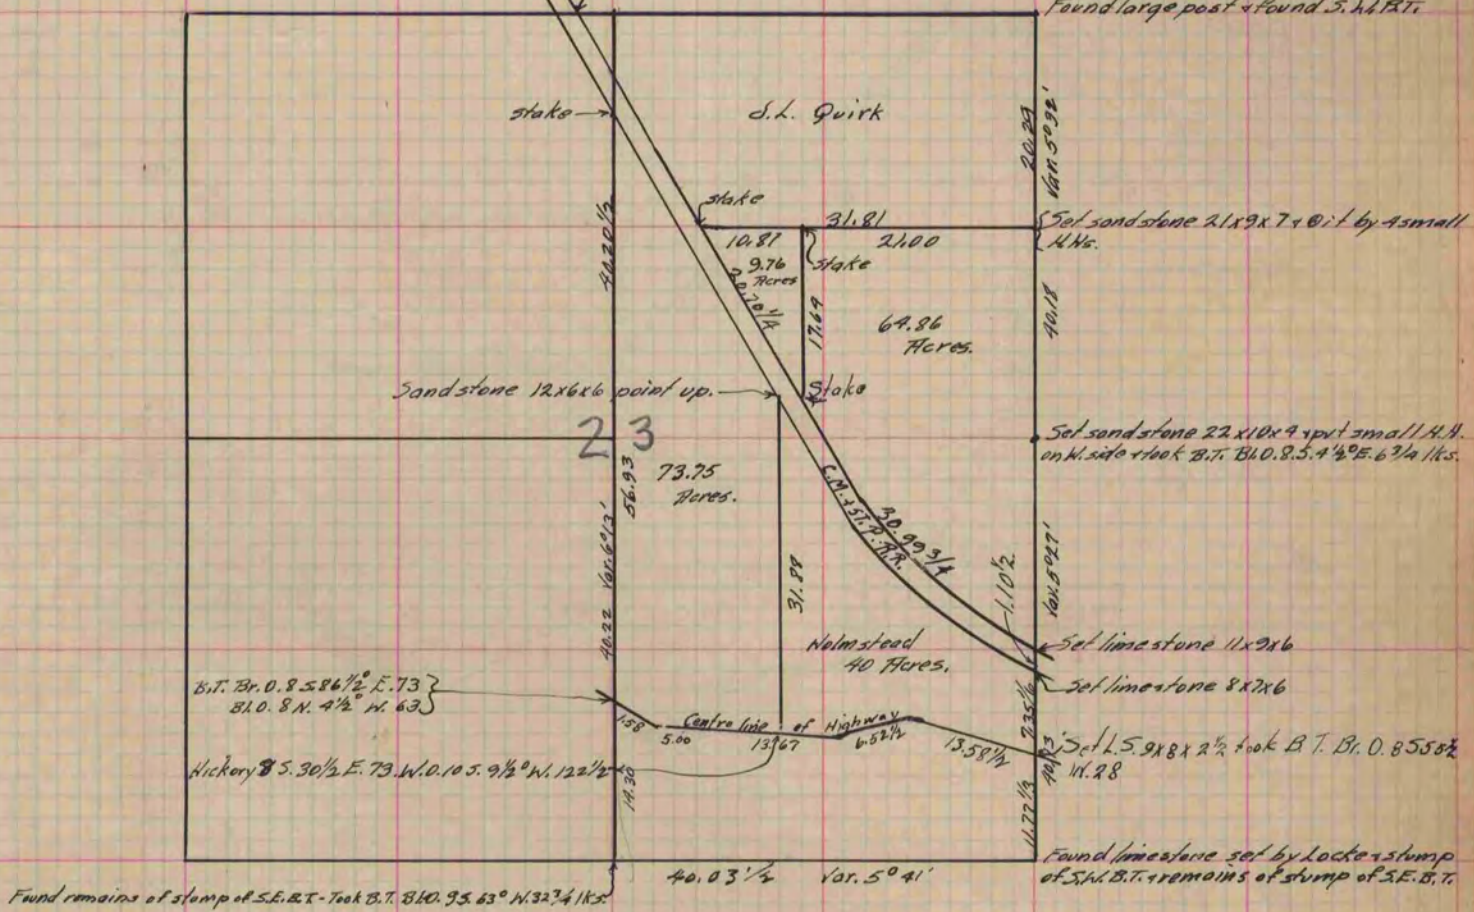

Copied From P. 308 Vol. 2 County Surveyor's Record.