

COUNTY BUILDING
IN CITY OF БЕЛОIT

PLAT AND RECORD


PG 304 JANESVILLE
REC. DAB

Of a Survey on Section 23 T 2 N. R 11 E. of the 4 P. M. in Plymouth Township
Rock County, Wisconsin, made June the 1936.

I hereby certify that the following is a correct record of said survey as made by me.

B. J. Bunney
County Surveyor.

COUNTY BUILDING
IN CITY OF БЕЛОIT

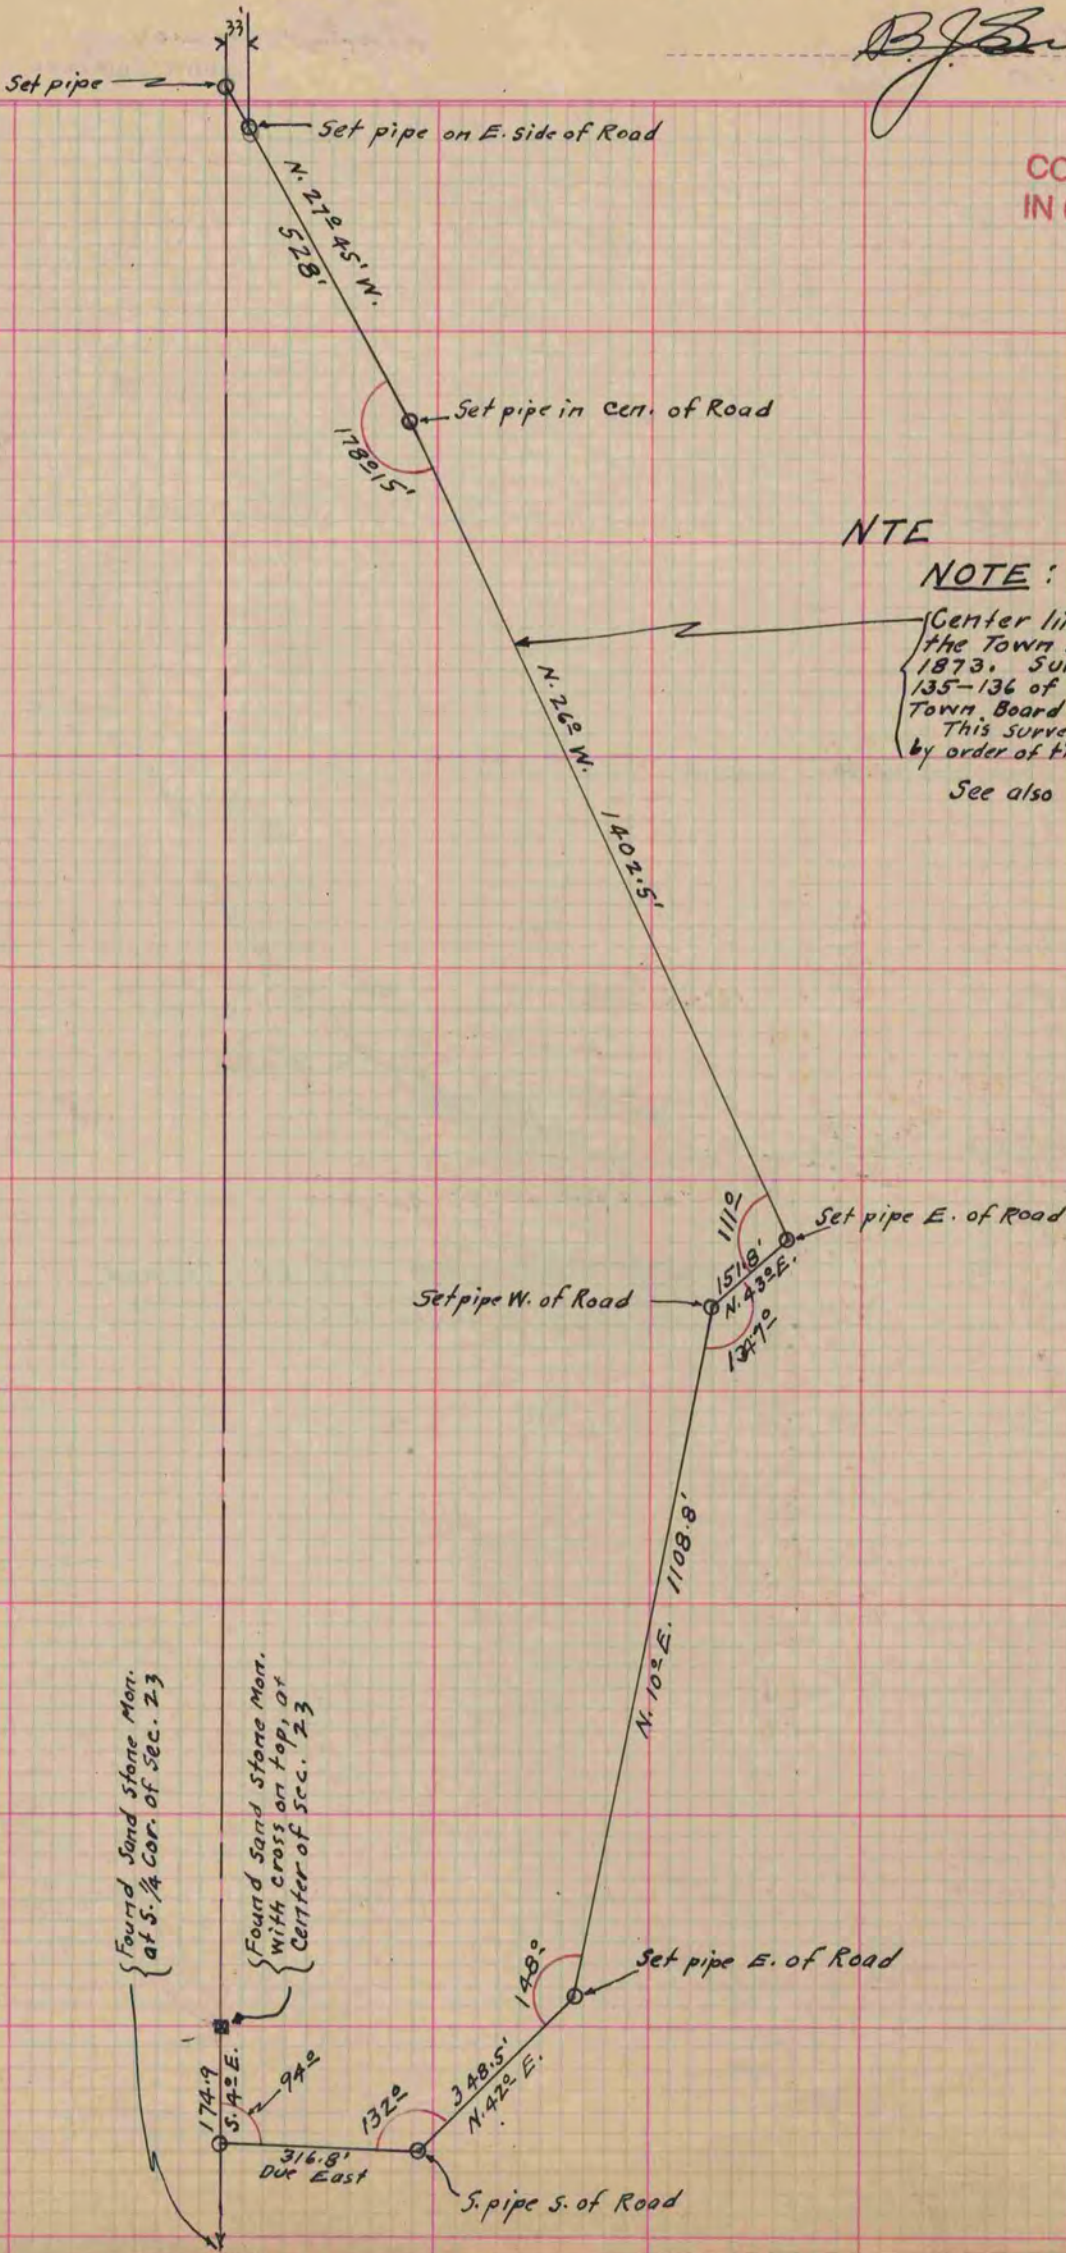

NTE

NOTE:

Center line of Road established by the Town Board of Plymouth, March 12, 1873. Survey notes copied from pages 135-136 of Vol. "B" of the Minutes of the Town Board of Plymouth. This survey is run out by me on the ground by order of the Town Board of 1936.

See also P.P. 578-579, Vol. "B"