

PLAT AND RECORD


Of a Survey on Section 34 T 4 R 10 E. of the 4 P. M. in Union Township

Rock County, Wisconsin, made Oct. the 21 1891

I hereby certify that the following is a correct record of said survey as made by me.

COUNTY BUILDING
IN CITY OF БЕЛОIT

(Signed) O. G. Bleedorn
O. G. B. Dep. County Surveyor.

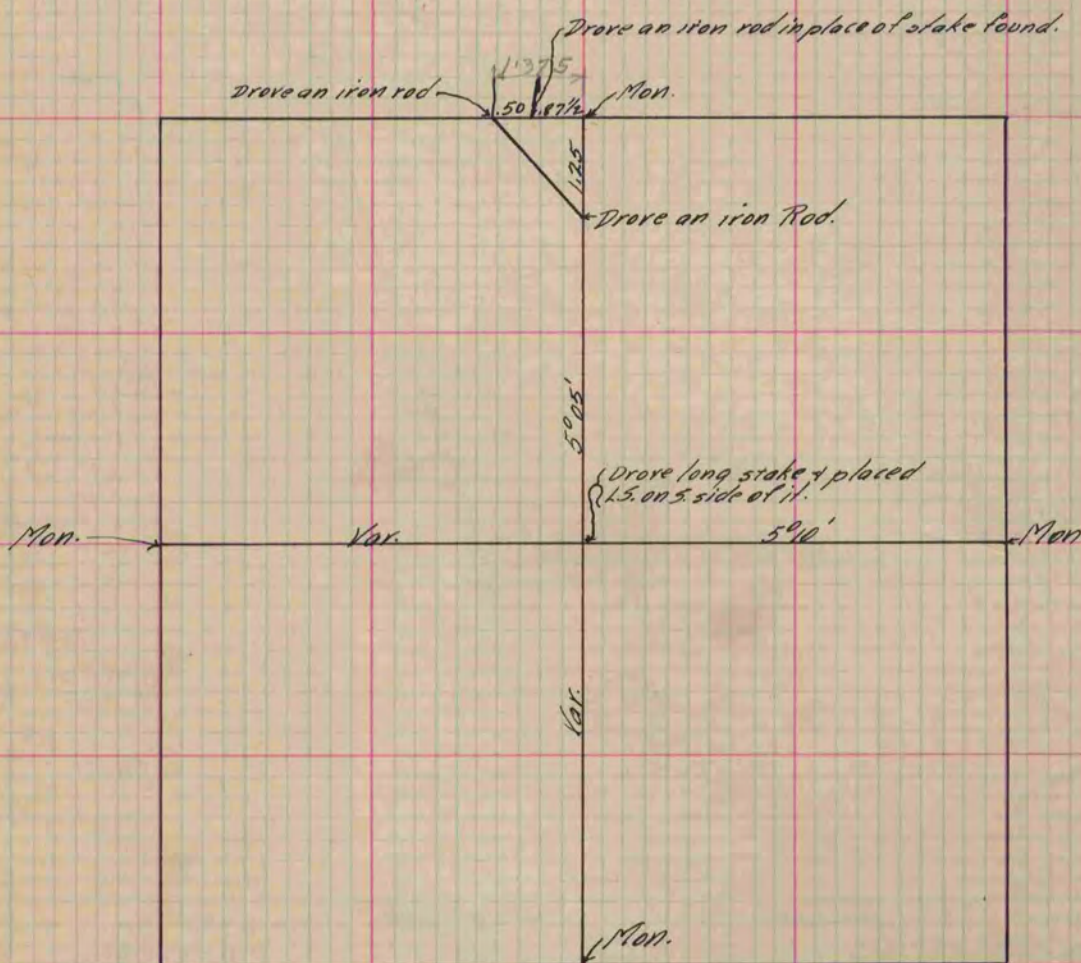

0.875 ch
 .50
 1.375 ch

Copied from P. 361 Vol. 2 County Surveyor's Record.