

PLAT AND RECORD

Of a Survey on Section 34 T 4 R 12 E. of the 4 P. M. in Fulton Township


Rock County, Wisconsin, made May the 30 1877

I hereby certify that the following is a correct record of said survey as made by me.

COUNTY BUILDING
IN CITY OF БЕЛОIT

(Signed) Edward Roper
CRP

County Surveyor.

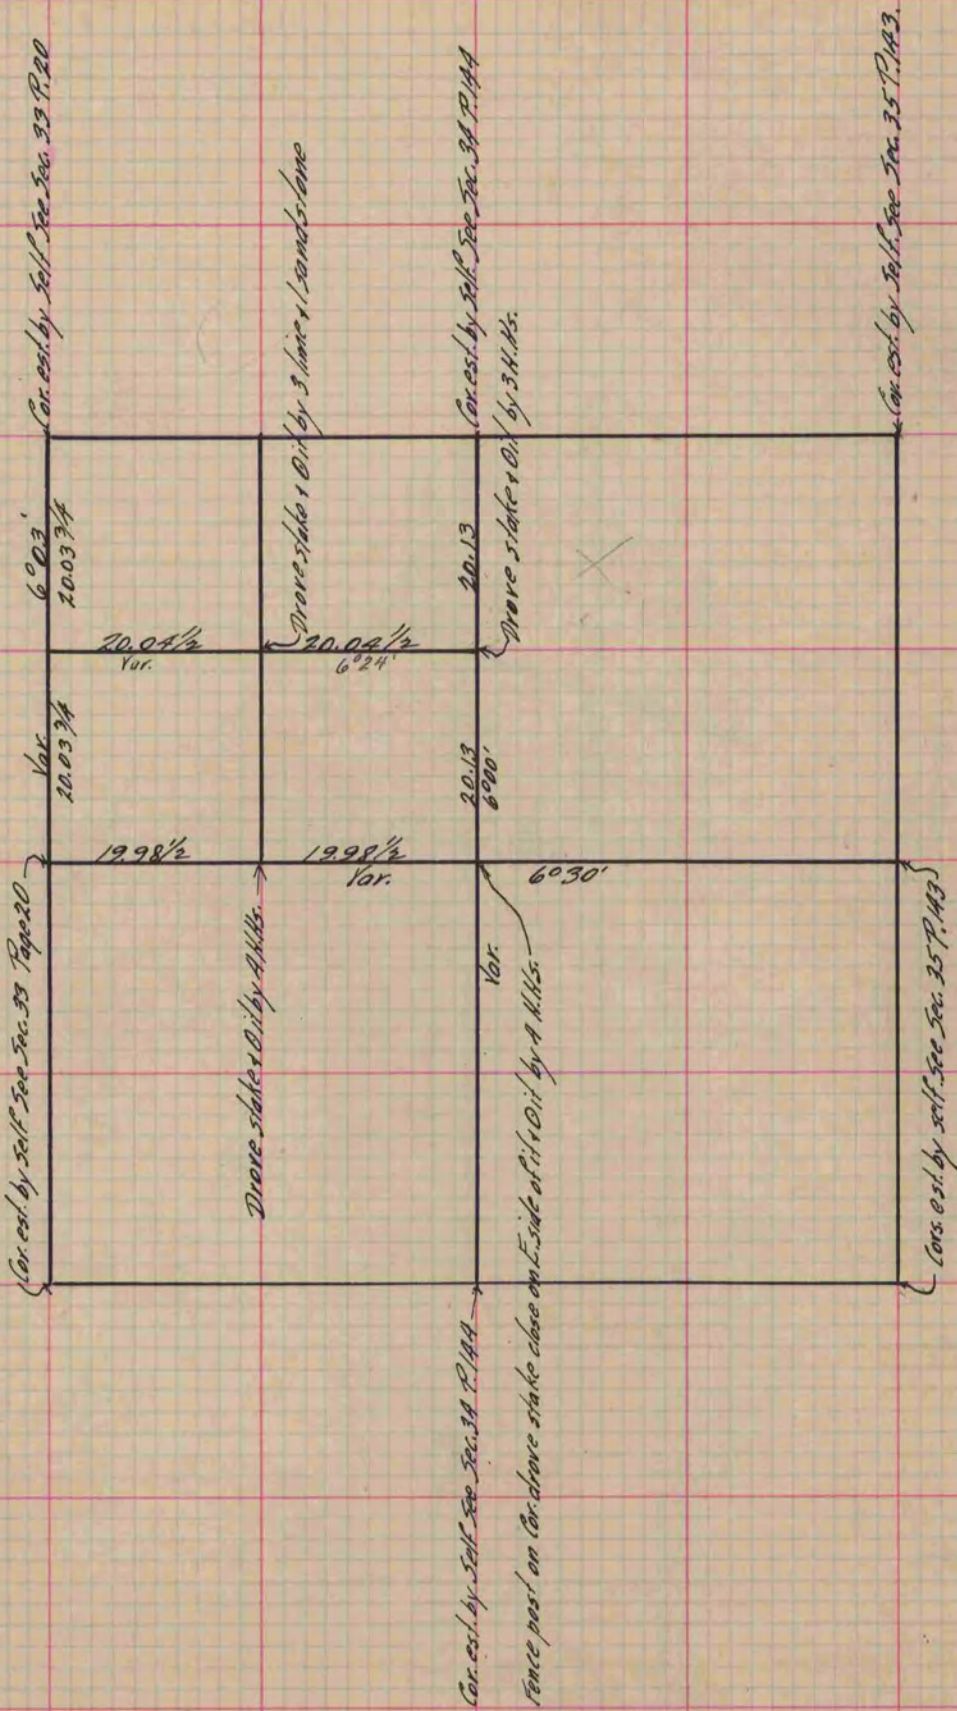

Copied from P. 183 Vol. 2 Original County Surveyor's Record.